



**ABELL  
SURVEYING & MAPPING  
DELANAN, WISCONSIN 53115  
414-728-6787**

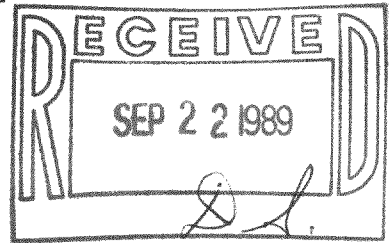

LAKE TRAIL

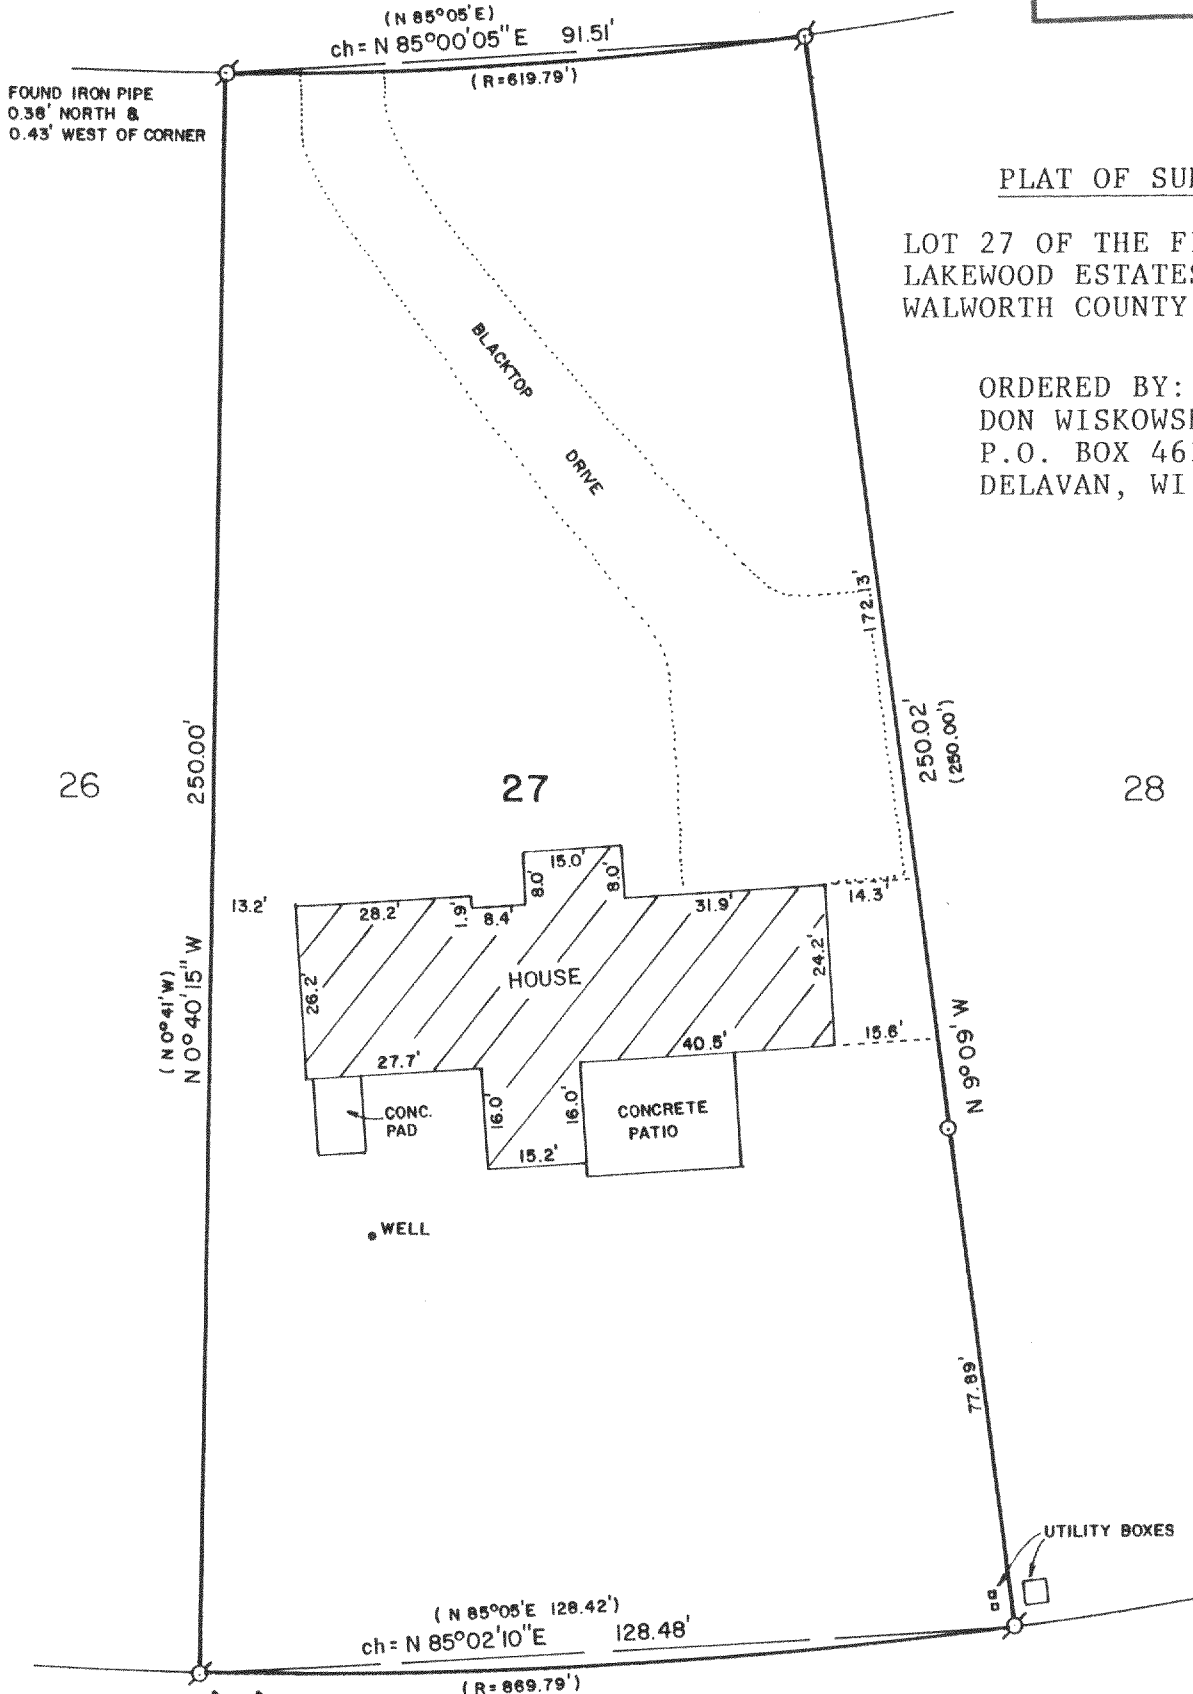

PLAT OF SURVEY OF

LOT 27 OF THE FIRST ADDITION TO  
LAKEWOOD ESTATES, T2N, R16E,  
WALWORTH COUNTY, WISCONSIN.

ORDERED BY:  
DON WISKOWSKI  
P.O. BOX 461  
DELANAN, WI. 53115



SCALE - 1"=30'

LEGEND

- ⊗ - IRON PIPE FOUND
- - IRON ROD SET
- ( ) - RECORDED AS

I, DAVID F. ABELL, DO HEREBY CERTIFY  
THAT I HAVE SURVEYED THE PROPERTY  
HEREON DESCRIBED ACCORDING TO THE  
OFFICIAL RECORDS AND THAT THE PLAT  
HEREON IS A CORRECT REPRESENTATION  
OF THE PROPERTY LINES TO THE BEST OF  
MY KNOWLEDGE AND BELIEF.

*David F. Abell*

DAVID F. ABELL  
WISCONSIN REGISTERED LAND SURVEYOR, S-1596

DATE June 28, 1989

JOB NUMBER - 89123

NOTE: THIS IS NOT A CERTIFIED COPY UNLESS SEALED.

FLA-7

216-1218