



ABELL
SURVEYING & MAPPING
 DELAVAN, WISCONSIN 53115
 414-728-6787

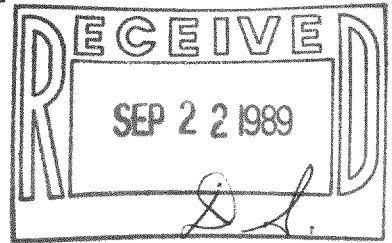

LAKE TRAIL

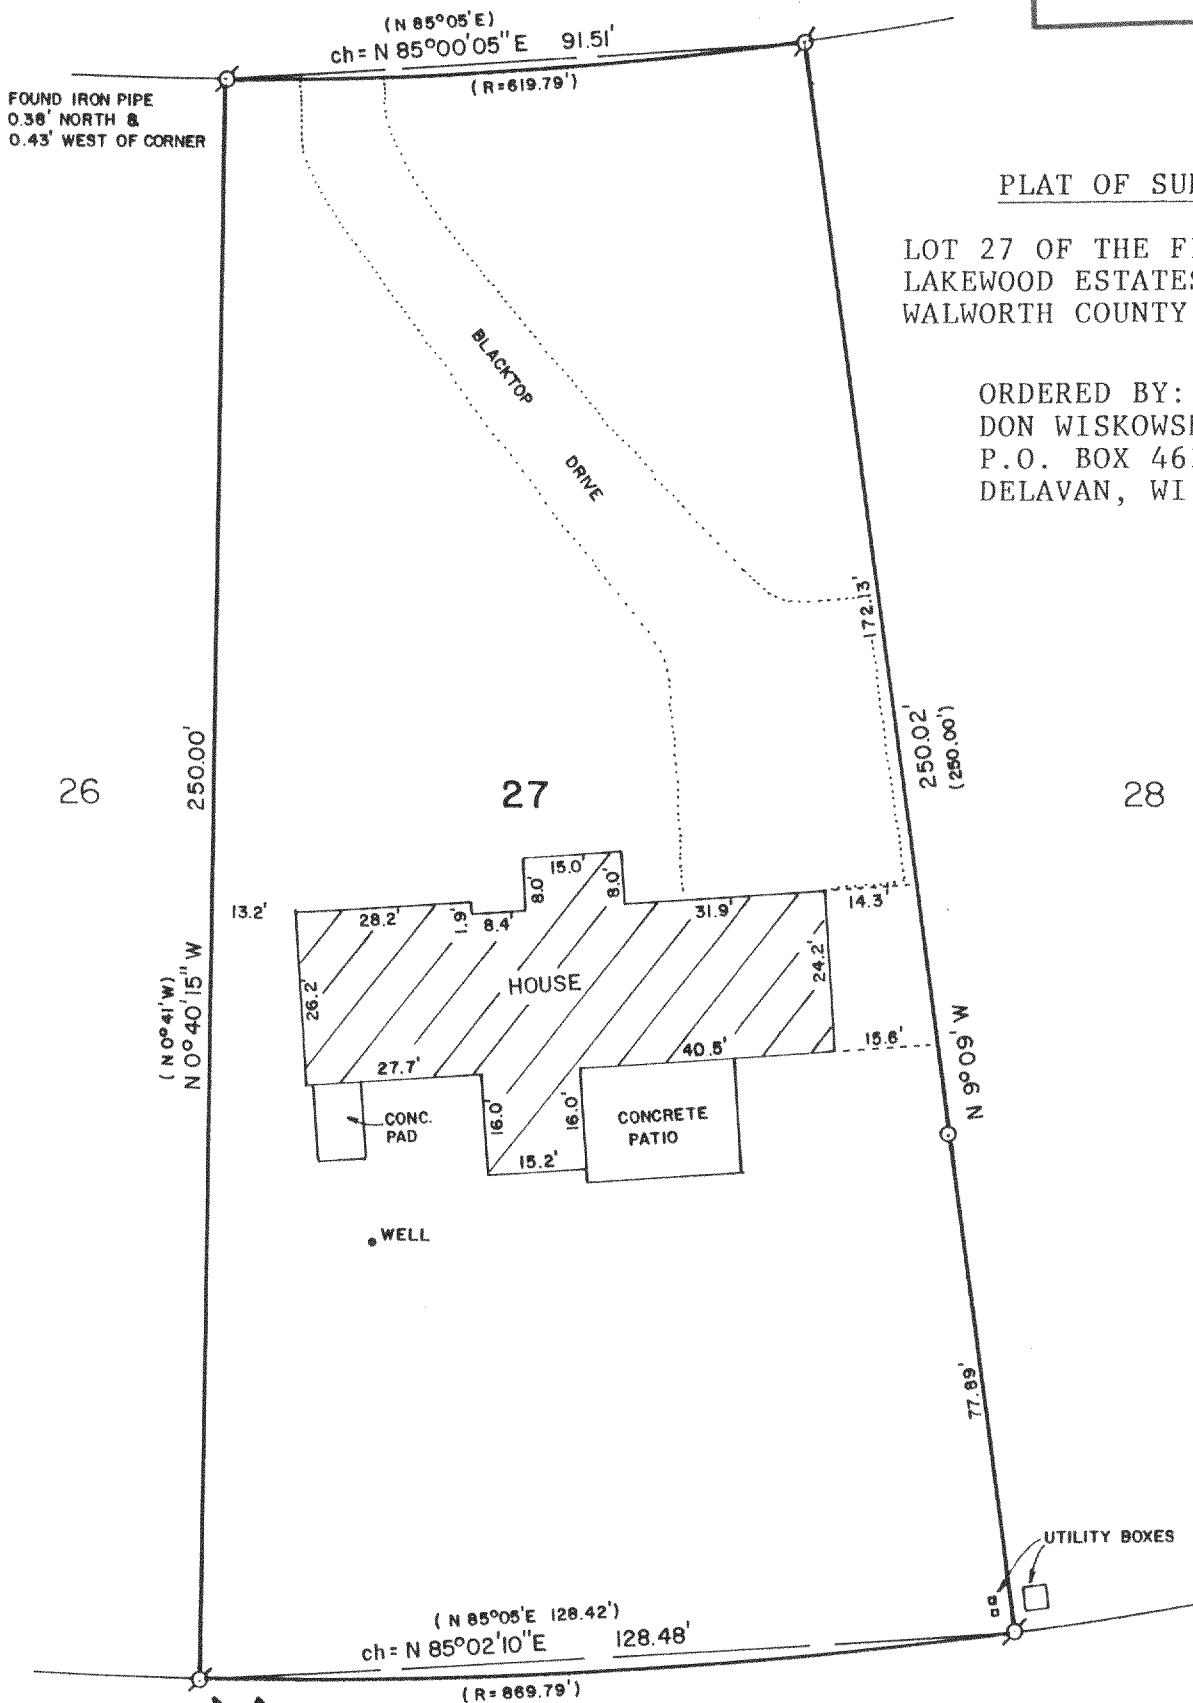

PLAT OF SURVEY OF

LOT 27 OF THE FIRST ADDITION TO
 LAKEWOOD ESTATES, T2N,R16E,
 WALWORTH COUNTY, WISCONSIN.

ORDERED BY:
 DON WISKOWSKI
 P.O. BOX 461
 DELAVAN, WI. 53115



SCALE - 1"=30'

LEGEND

- ⊗ - IRON PIPE FOUND
- - IRON ROD SET
- () - RECORDED AS

I, DAVID F. ABELL, DO HEREBY CERTIFY
 THAT I HAVE SURVEYED THE PROPERTY
 HEREON DESCRIBED ACCORDING TO THE
 OFFICIAL RECORDS AND THAT THE PLAT
 HEREON IS A CORRECT REPRESENTATION
 OF THE PROPERTY LINES TO THE BEST OF
 MY KNOWLEDGE AND BELIEF.

David F. Abell

DAVID F. ABELL
 WISCONSIN REGISTERED LAND SURVEYOR, S-1596

DATE June 28, 1989

JOB NUMBER - 89/23

NOTE: THIS IS NOT A CERTIFIED COPY UNLESS SEALED.

FILED - 7

216-1218