
## ABELL SURVEYING & MAPPING

DELAVAN, WISCONSIN 53115 414-728-6737

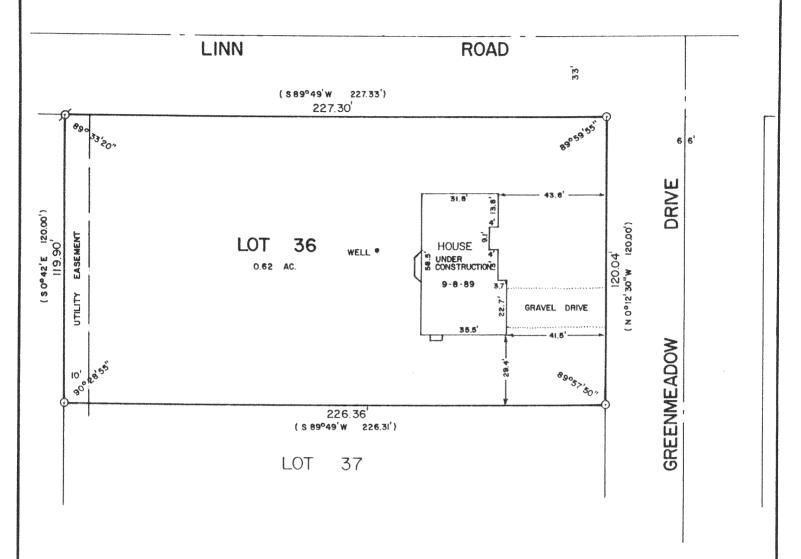


## PLAT OF SURVEY OF

LOT 36 OF OAK MEADOW SUBDIVISION, LOCATED IN THE NORTHEAST 1/4 OF SECTION 29, T2N, R16E, WALWORTH COUNTY, WISCONSIN.

ORDERED BY: DAVE STEBNITZ

ROUTE 1, BOX 9

DELAVAN, WI. 53115

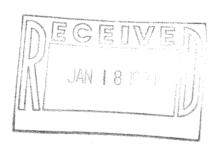



SCALE - 1"=40'

LEGEND Ø - IRON PIPE FOUND
O - IRON ROD FOUND

)- RECORDED AS

I, DAVID F. ABELL, DO HEREBY CERTIFY THAT I HAVE SURVEYED THE PROPERTY HEREON DESCRIBED ACCORDING TO THE OFFICIAL RECORDS AND THAT THE PLAT HEREON IS A CORRECT REPRESENTATION OF THE PROPERTY LINES TO THE BEST OF MY KNOWLEDGE AND BELIEF.

DAVID F ABELL

WISCONSIN REGISTERED LAND SURVEYOR, S-1596

*/989* JOB NUMBER - 89196

NOTE: THIS IS NOT A CERTIFIED COPY UNLESS SEALED.