
## ABELL SURVEYING & MAPPING DELAVAN, WISCONSIN 53115 414-728-6787



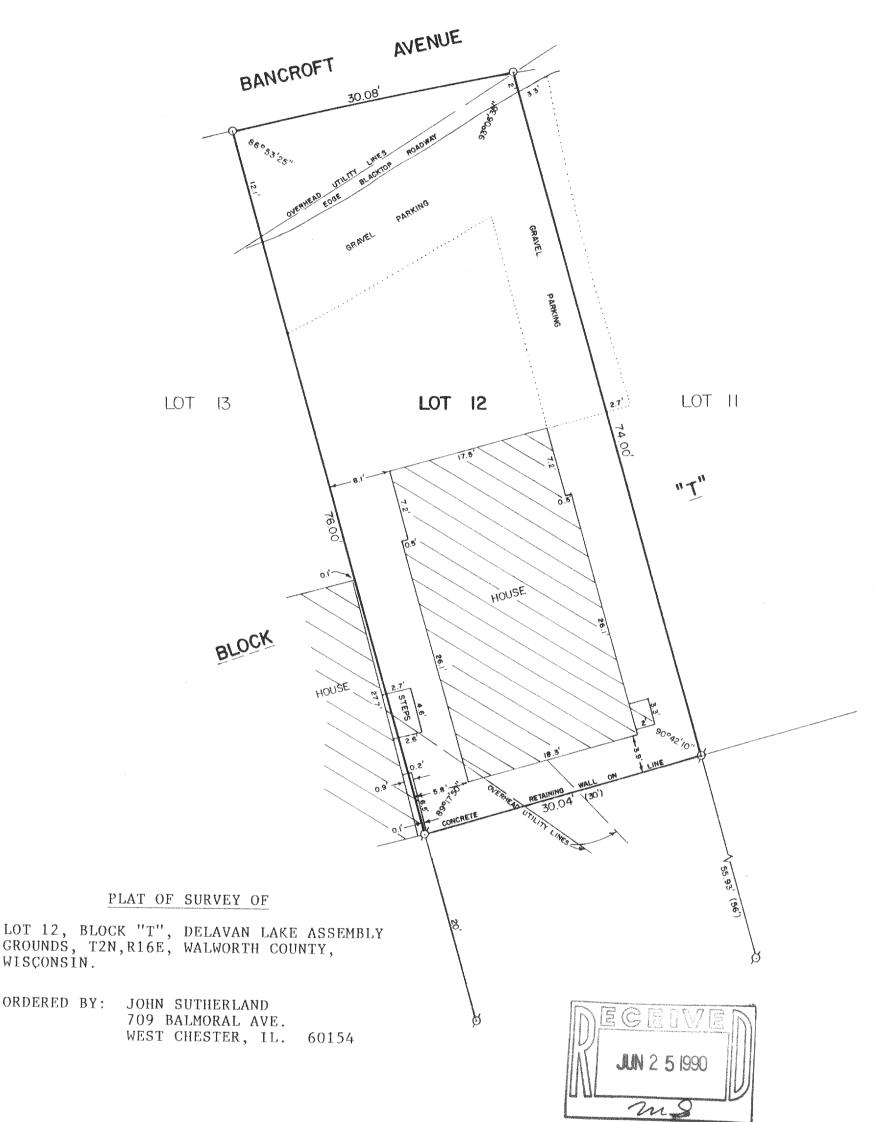

SCALE - 1"=10'

LEGEND Ø - IRON PIPE FOUND

O - IRON ROD SET IN BLACKTOP ROAD

( )- RECORDED AS

WISCONSIN.

ORDERED BY:

I, DAVID F. ABELL, DO HEREBY CERTIFY THAT I HAVE SURVEYED THE PROPERTY HEREON DESCRIBED ACCORDING TO THE OFFICIAL RECORDS AND THAT THE PLAT HEREON IS A CORRECT REPRESENTATION OF THE PROPERTY LINES TO THE BEST OF MY KNOWLEDGE AND BELIEF.

DAVID F. ABELL WISCONSIN REGISTERED LAND SURVEYOR, S-1596

May 23, 1990.

JOB NUMBER - 90092 NOTE: THIS IS NOT A CERTIFIED COPY UNLESS SEALED.