
ABELL SURVEYING & MAPPING DELAVAN, WISCONSIN 55115

414-728-6787

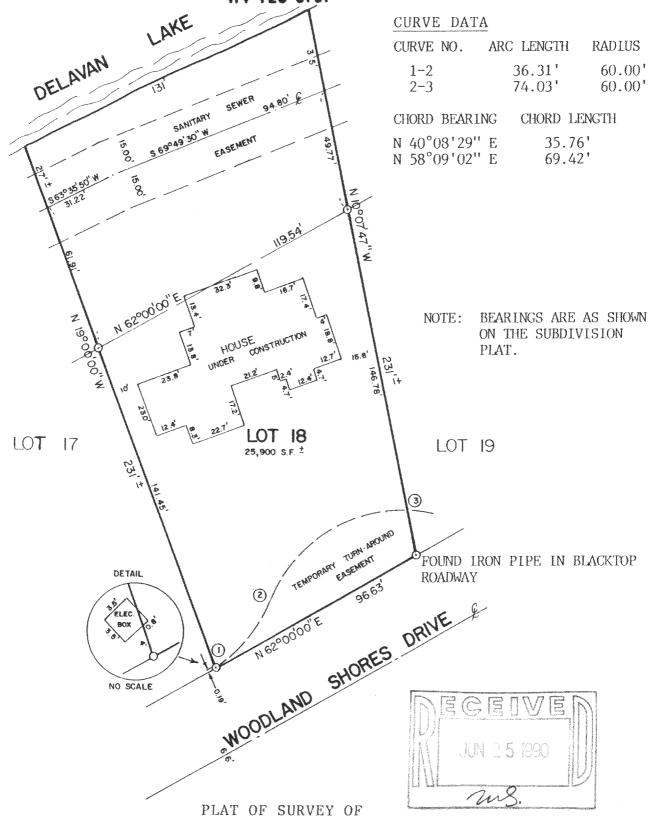

LOT 18 OF WOODLAND SHORES SUBDIVISION, LOCATED IN T2N,R16E, WALWORTH COUNTY, WISCONSIN.

ORDERED BY:

ANCHOR SAVINGS & LOAN

P.O. BOX 997

LAKE GENEVA, WI. 53147

N

SCALE - 1"=40'

O - IRON PIPE FOUND

I HERBY CERTIFY THAT I HAVE SURVEYED THE ABOVE DESCRIBED PROPERTY AND THAT THE ABOVE MAP IS A TRUE REPRESENTATION THEREOF AND SHOWS THE SIZE AND LOCATION OF THE PROPERTY, ITS EXTERIOR BOUNDARIES, THE LOCATION OF ALL VISIBLE STRUCTURES AND DIHERSIONS OF ALL PRINCIPAL BUILDINGS THEREON, BOUNDARY FENCES, APPARENT EASEMENTS, ROADWAYS AND VISIBLE ENCROACHMENTS, IF ANY, TO THE BEST OF MY KNOWLEDGE AND BELLEF.

THIS SURVEY IS MADE FOR THE USE OF THE PRESENT OWNERS OF THE PROPERTY, AND ALSO THOSE WHO PURCHASE, HORTCAGE, OR GUARANTEE THE TITLE THERETO WITHIN ONE (1) YEAR FROM DATE HEREOF.

Said 7. abell

DAVID F. ABELL WISCONSIN REGISTERED LAND SURVEYOR, S-1596

February 26, 1990
DATE JOB NUMBER - 90022
NOTE: THIS IS NOT A CERTIFIED COPY UNLESS SEALED.

TAX# FWLS-18

216-1268