

SURVEYING & SUBDIVIDING
DEHAVAN, WISCONSIN 53115

EAST 66.00

LOT 3

North end of
Woven Wire Fence

North end of cyclone
fence line —

X = 3/4" Iron Pipe Found 2' below surface. Set 1 1/4" X 24" Iron pipe at ground level.

Survey ordered by: Century 21, Skandia
Realty
312 South 7th Street
Delavan, WI

0.15' W.
of fence



STATE OF WISCONSIN) SS
COUNTY OF WALWORTH)

I, George T. Dunham, Surveyor, certify that I have surveyed the property described as follows:

Lot 3 in The Hamlet of Bon Secour, a subdivision located in Section 29, T 2 N, R 16 E, Walworth County, Wisconsin, and that the plat shown hereon is a correct representation thereof and shows the size and location of the property, its exterior boundaries, the location of all visible structures and dimensions of all principal buildings thereon, boundary fences, apparent easements, roadways and visible encroachments, if any, and that I have surveyed the property hereon described, according to the official records, to the best of my knowledge and belief.

July 29, 1989

George T. Dunham
George T. Dunham, Surveyor

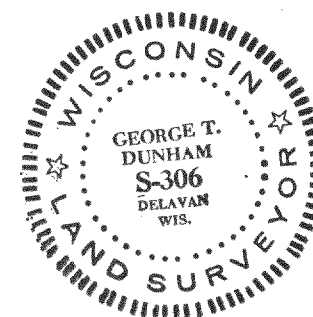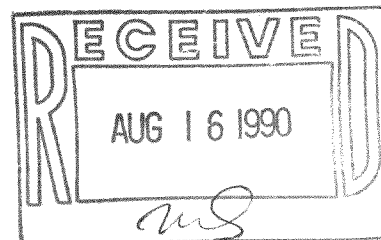

DE LAVAN
LAKE

Survey # 216-1296

TAX KEY # FRO 00005