


DUNHAM SURVEYING, S.C.  
SURVEYING & SUBDIVIDING  
DELAVAN, WISCONSIN 53115

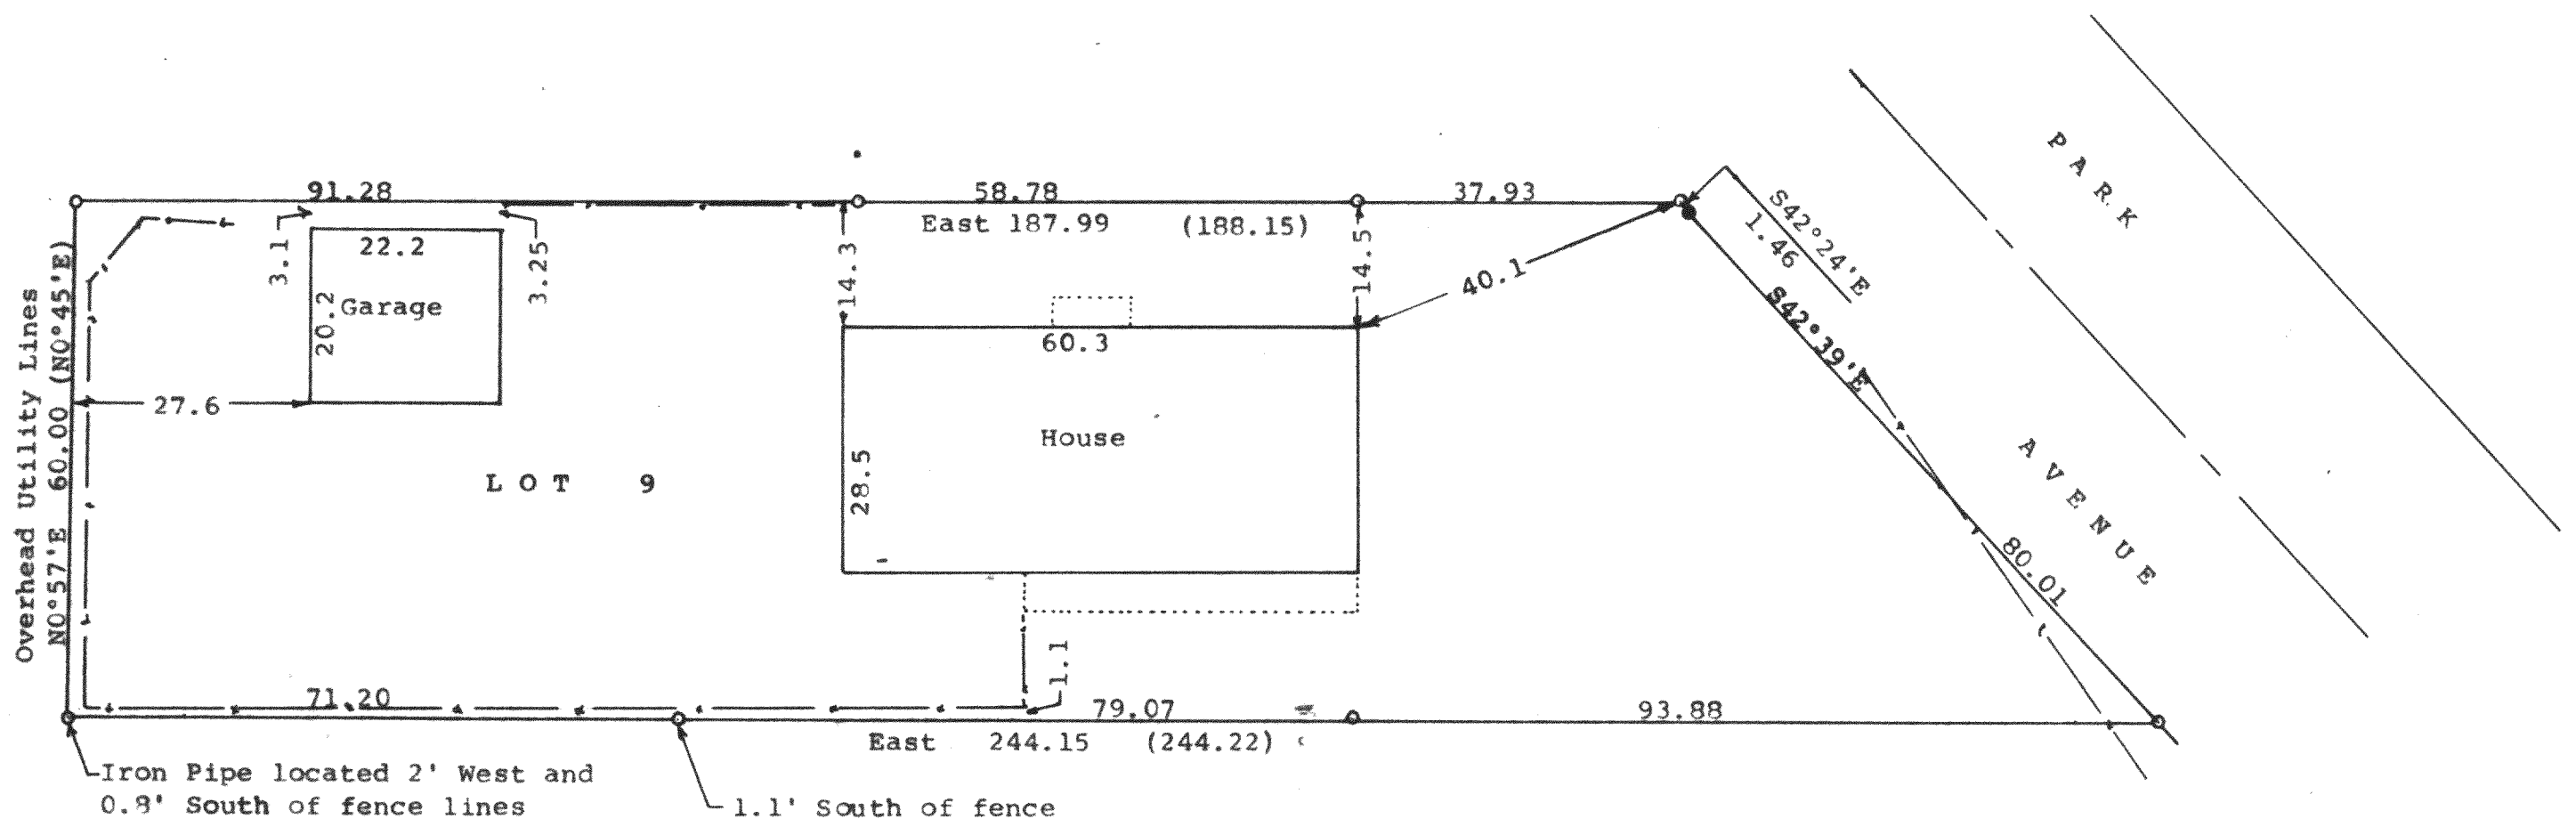

Scale - 1" = 20'  
 ● = concrete monument found  
 ○ = Iron Pipe Found  
 (0.00) = recorded information  
 --- = Fence Line  
 Survey ordered by: Century 21, Skandia Realty  
 312 South 7th Street  
 Delavan, WI 53115



STATE OF WISCONSIN) SS  
 COUNTY OF WALWORTH)

I, George T. Dunham, Surveyor, certify that I have surveyed the property described as follows:

Lot 9 in Block 4 of Woodlawn Bay Community, a subdivision located in Fractional Sections 21 and 28, T 2 N, R 16 E, Walworth County, Wisconsin,

and that the plat shown hereon is a correct representation thereof and shows the size and location of the property, its exterior boundaries, the location of all visible structures and dimensions of all principal buildings thereon, boundary fences, apparent easements, roadways and visible encroachments, if any, and that I have surveyed the property hereon described, according to the official records, to the best of my knowledge and belief.  
 July 13, 1989

*George T. Dunham*  
 George T. Dunham, Surveyor

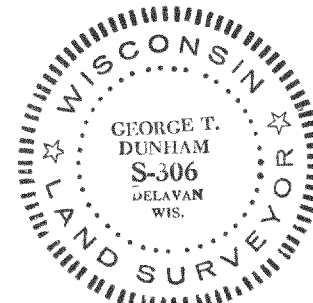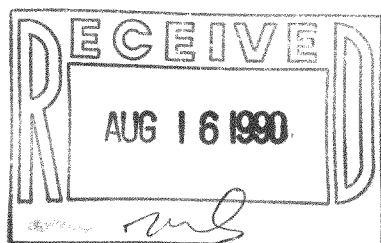

Survey # 216-1298

TAX KEY # FWO 00047