
ABELL SURVEYING & MAPPING DELAVAN, WISCONSIN 53115 414-728-6737



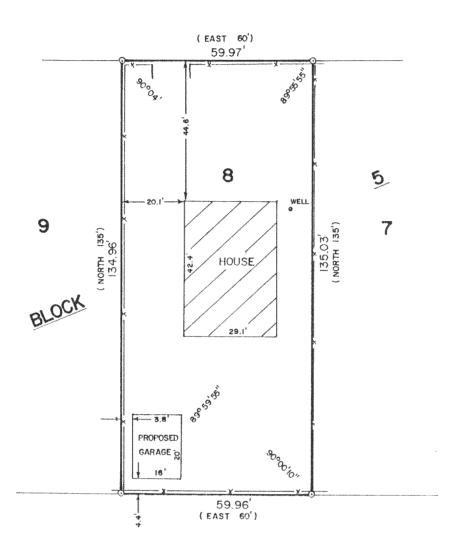

PLAT OF SURVEY OF


LOT 8, BLOCK 5 OF DELMAR SUBDIVISION, T2N, R16E WALWORTH COUNTY, WISCONSIN.

ORDERED BY:

ED VAN

RT. 3, BOX 239

DELAVAN, WI. 53115

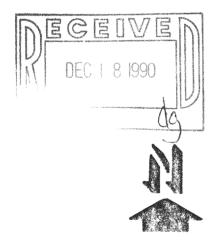

SCALE - 1"=30'

LEGEND

○ - IRON PIPE FOUND

()- RECORDED AS

-- FENCE

I, DAVID F. ABELL, DO HEREBY CERTIFY THAT I HAVE SURVEYED THE PROPERTY HEREON DESCRIBED ACCORDING TO THE OFFICIAL RECORDS AND THAT THE PLAT HEREON IS A CORRECT REPRESENTATION OF THE PROPERTY LINES TO THE BEST OF MY KNOWLEDGE AND BELIEF.

DAVID

7. Welf WISCONSIN REGISTERED LAND SURVEYOR, S-1596

DAZE JOB NUMBER - 90140 NOTE: THIS IS NOT A CERTIFIED COPY UNLESS SEALED.

216-1370