
ABELL SURVEYING & MAPPING DELAVAN, WISCONSIN 63116 414-720-6787

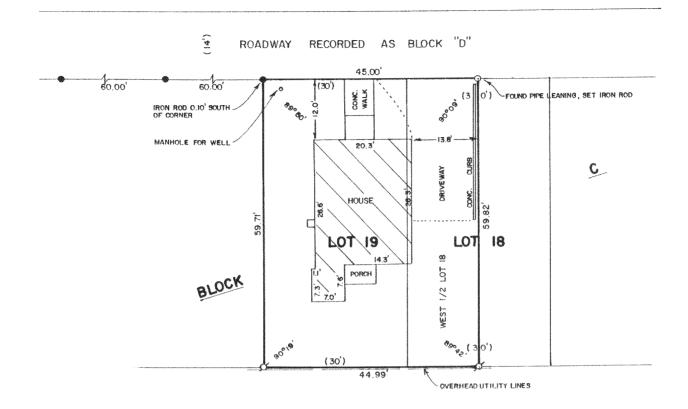

PLAT OF SURVEY OF

LOT 19 AND THE WEST 1/2 OF LOT 18, BLOCK "C", JACKSON'S SUBDIVISION, T2N,R16E, WALWORTH COUNTY, WISCONSIN.

ORDERED BY:

VACATION PROPERTIES NETWORK

101 BROAD STREET

LAKE GENEVA, WI. 53147





1"=30" SCALE

LEGEND

σ - IRON PIPE FOUND

• - IRON ROD FOUND

o - IRON ROD SET

()- RECORDED AS

I HERBY CERTIFY THAT I HAVE SURVEYED THE ABOVE DESCRIBED PROPERTY AND THAT THE ABOVE MAP IS A TRUE REPRESENTATION THEREOF AND SHOWS THE SIZE AND LOCATION OF THE PROPERTY, ITS EXTERIOR BOUNDARIES, THE LOCATION OF ALL VISIBLE STRUCTURES AND DIMENSIONS OF ALL PRINCIPAL BUILDINGS THEREON, BOUNDARY FENCES, APPARENT EASEMENTS, ROADWAYS AND VISIBLE ENCROACHMENTS, IF ANY, TO THE BEST OF MY KNOWLEDGE AND BELIEF.

THIS SURVEY IS HADE FOR THE USE OF THE PRESENT OWNERS OF THE PROPERTY, AND ALSO THOSE WHO PURCHASE, MORTGAGE, OR GUARANTEE THE TITLE THERETO WITHIN ONE (1) YEAR FROM DATE HEREOF.

DAVID F. ABELL WISCONSIN REGISTERED LAND SURVEYOR, S 1596

October 5, 1990

90201

NOTE: THIS IS NOT A CERTIFIED COPY UNLESS SEALED.