


ABELL
SURVEYING & MAPPING

DELAVAN, WISCONSIN 53115
414-728-6737

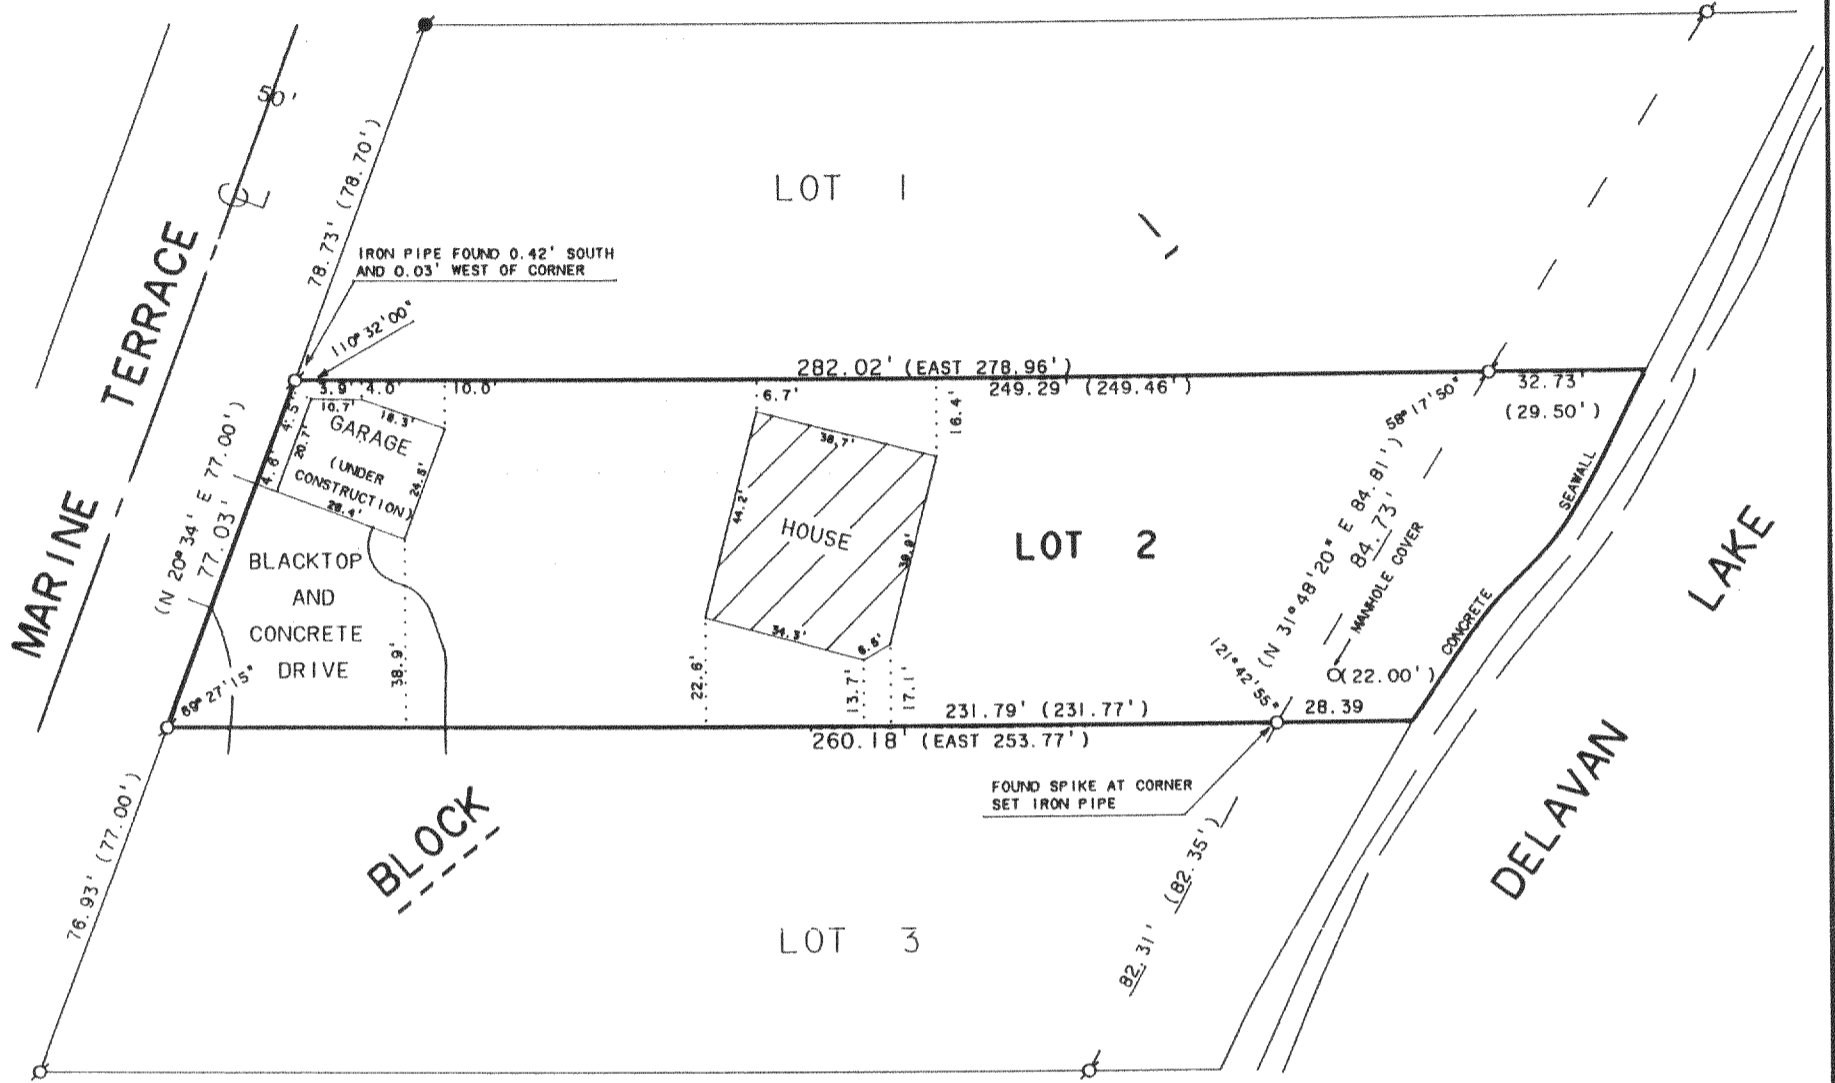

PLAT OF SURVEY OF

LOT 2, BLOCK 1, WOODLAWN BAY COMMUNITY SUBDIVISION,
LOCATED IN T2N, R16E, WALWORTH COUNTY, WISCONSIN.




SCALE 1"=40'

LEGEND

- ⊗ - IRON PIPE FOUND
- - CONCRETE MONUMENT FOUND
- - IRON PIPE SET
- () - RECORDED AS

ORDERED BY: STEBNITZ BUILDERS
P.O. BOX 526
DELAVAN, WI. 53115

NOTE: LOCATION OF BLACKTOP AND CONCRETE DRIVE
IS APPROXIMATE DUE TO SNOW COVER.

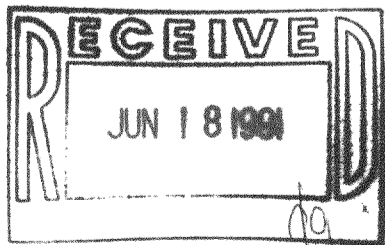

I, DAVID F. ABELL, DO HEREBY CERTIFY THAT I HAVE SURVEYED THE PROPERTY HEREON DESCRIBED ACCORDING TO THE OFFICAL RECORDS AND THAT THE PLAT HEREON IS A CORRECT REPRESENTATION OF THE PROPERTY LINES TO THE BEST OF MY KNOWLEDGE AND BELIEF.

David F. Abell

DAVID F. ABELL
WISCONSIN REGISTERED LAND SURVEYOR, S-1596

January 15, 1991

DATE JOB NUMBER - 91010

NOTE: THIS IS NOT A CERTIFIED COPY UNLESS SEALED.