
ABELL SURVEYING & MAPPING

DELAVAN, WISCONSIN 53115 414-728-6737

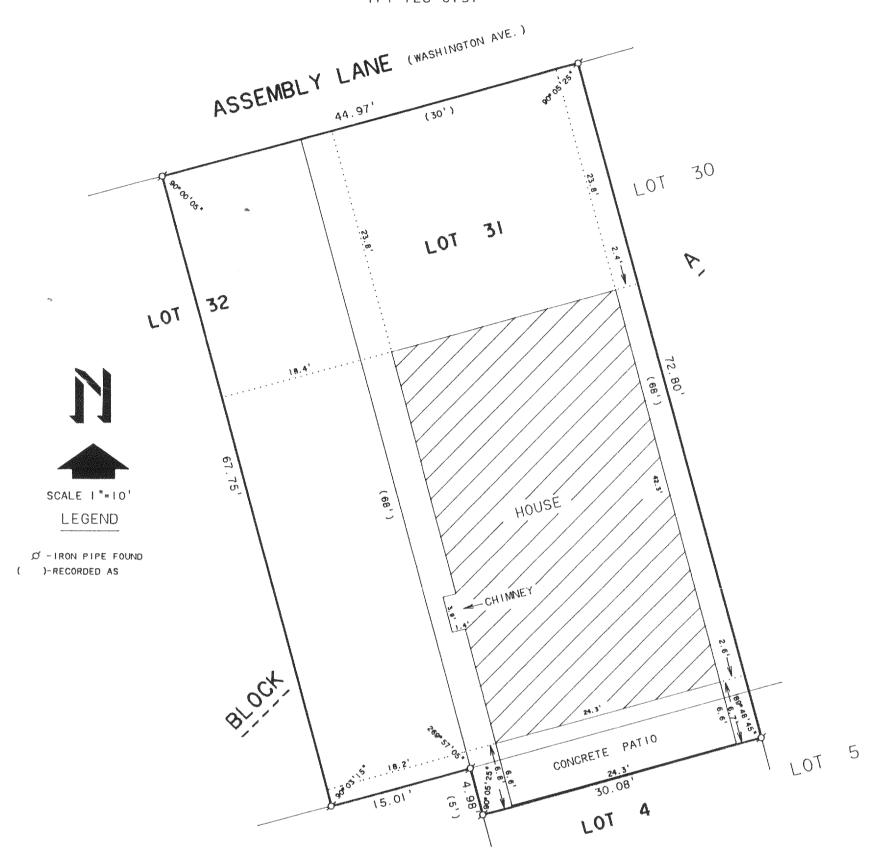

LOT 3

PLAT OF SURVEY OF

LOT 31. THE EAST 1/2 OF LOT 32 AND THE NORTH 5 FEET OF LOT 4. BLOCK A. DELAVAN LAKE ASSEMBLY GROUNDS. T2N.R16E. WALWORTH COUNTY, WISCONSIN.



ORDERED BY: RICHARD SANDERS
1125 MORNINGSIDE DR.
ELGIN. IL. 60123

I. DAVID F. ABELL, DO HEREBY CERTIFY THAT I HAVE SURVEYED THE PROPERTY HEREON DESCRIBED ACCORDING TO THE OFFICAL RECORDS AND THAT THE PLAT HEREON IS A CORRECT REPRESENTATION OF THE PROPERTY LINES TO THE BEST OF MY KNOWLEDGE AND

David 7. abels

DAVID F. ABELL

WISCONSIN REGISTERED LAND SURVEYOR, S-1596

March 21, 1991

JOB NUMBER - 91041

NOTE: THIS IS NOT A CERTIFIED COPY UNLESS SEALED.