


ABELL
SURVEYING & MAPPING


DEHAVAN, WISCONSIN 53115

414-728-6737

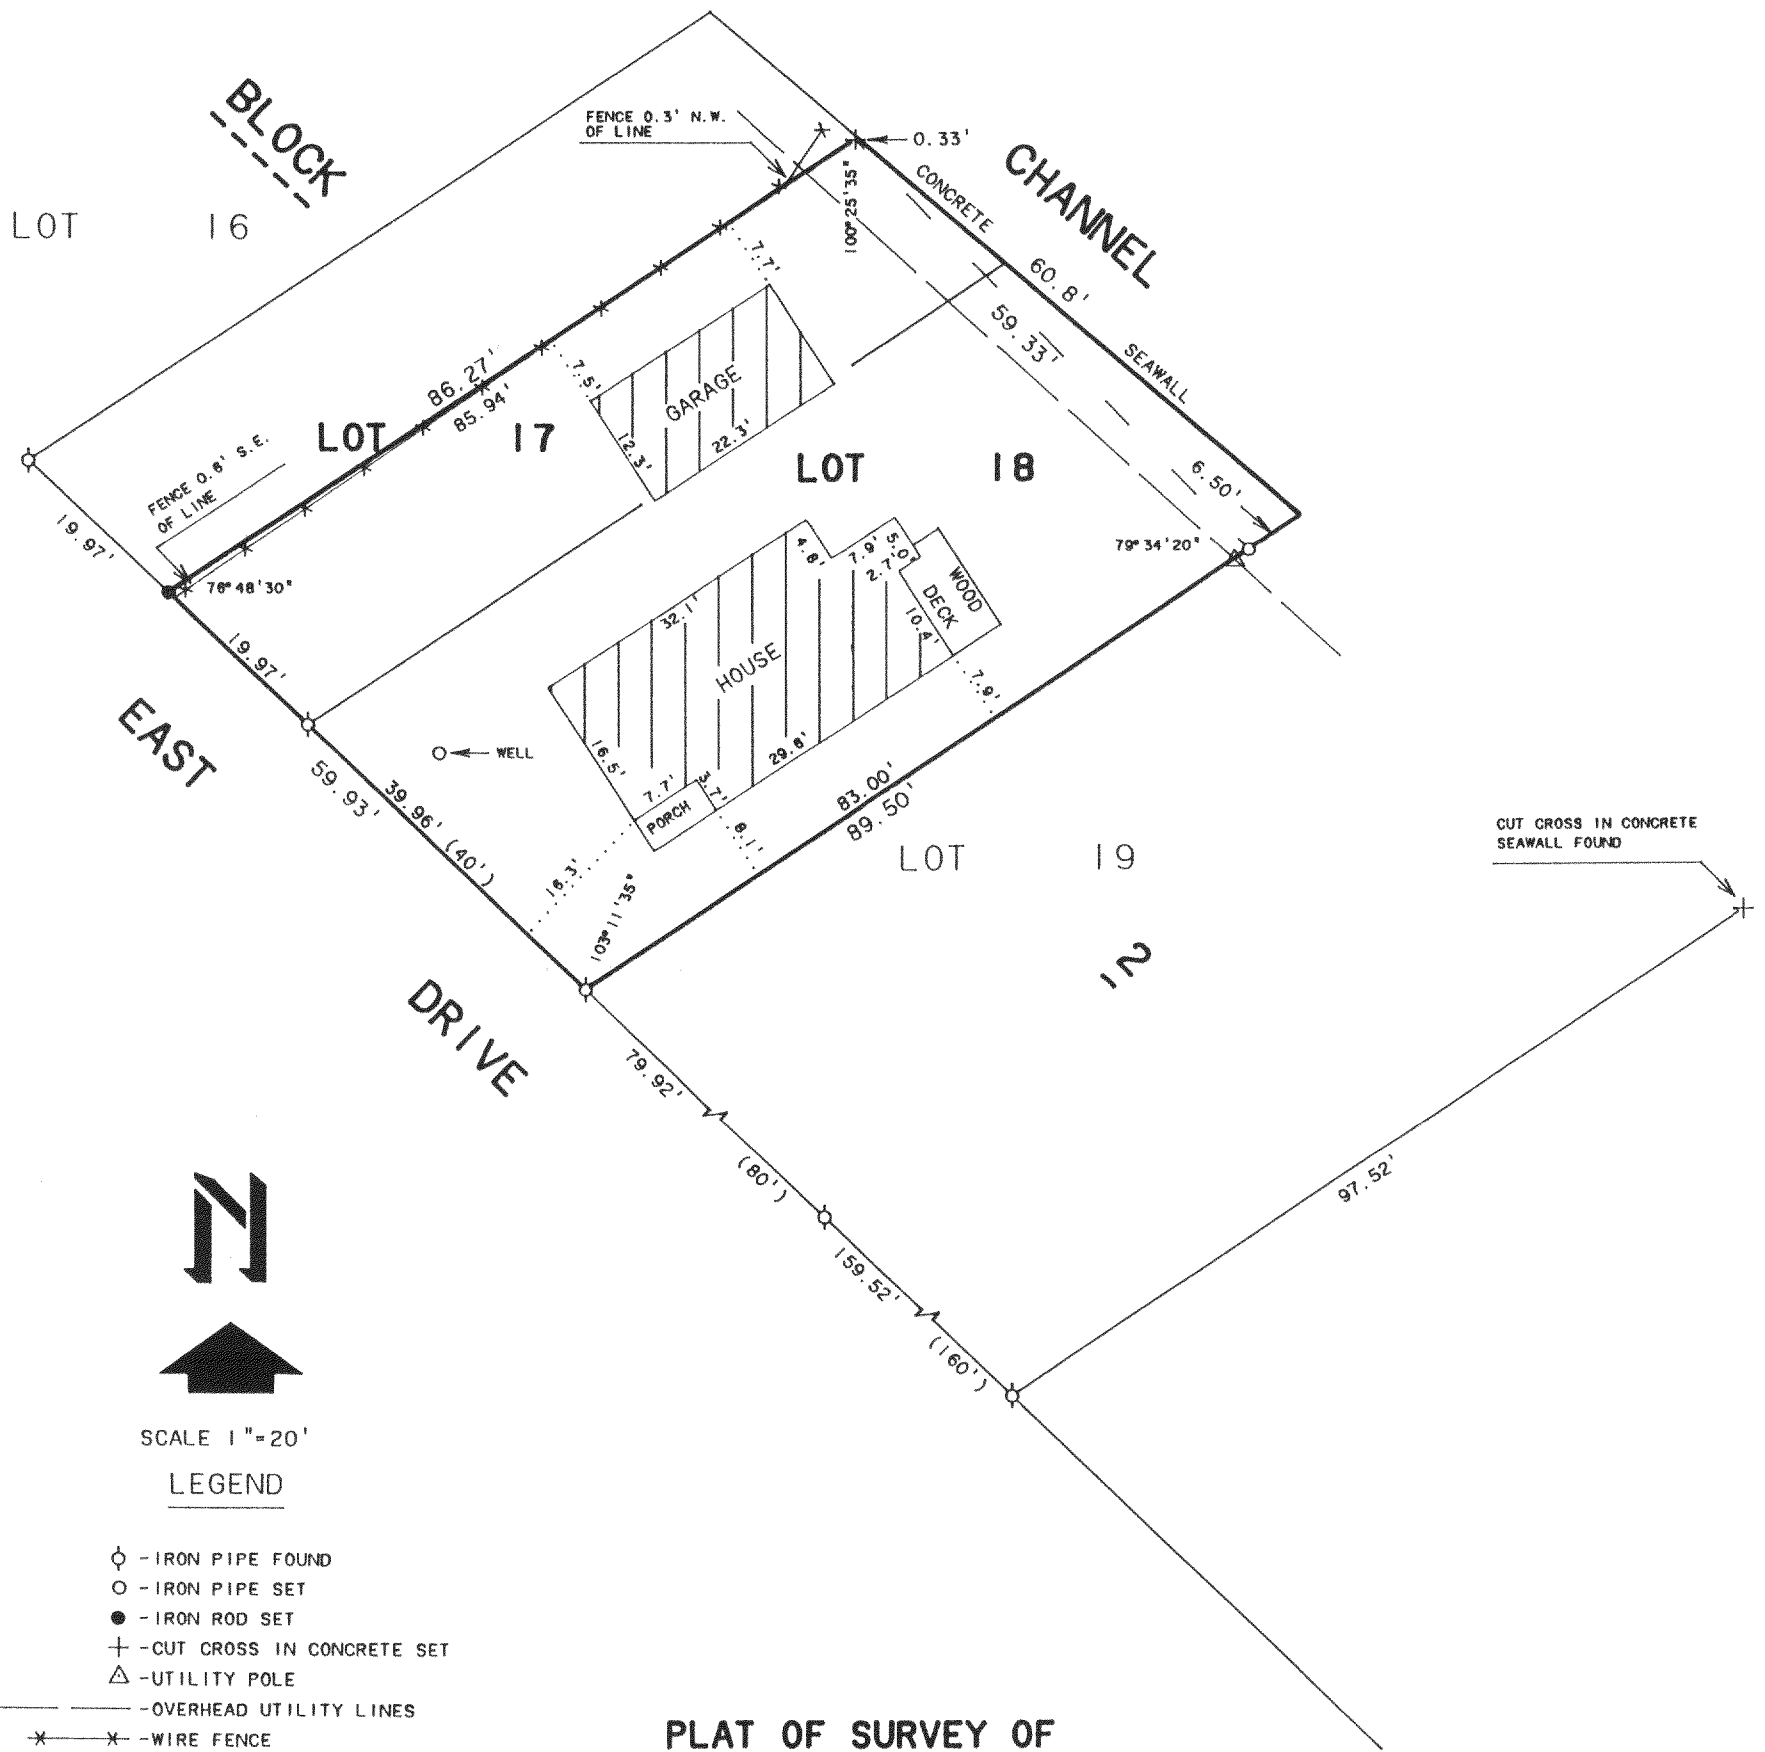

PLAT OF SURVEY OF

Lot 18 in Block 2 and the Southerly 1/2 of Lot 17 in Block 2, being that part of Lot 17 paralleling Lot 18 and measured from a point on East Drive equi-distant from the Northwest and Southwest corners of said lot and running to the channel to a point equi-distant between the Northeast and Southeast corners of said lot in Block 2 in South Shore Manor in the SE 1/3 of Section 32, T2N, R16E, said property being in the County of Walworth and State of Wisconsin.

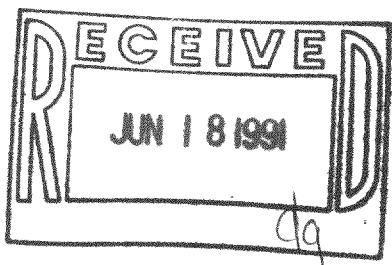

ORDERED BY: CENTURY 21-SKANDIA REALTY
312 S. 7th STREET
DEHAVAN, WI. 53115

I HEREBY CERTIFY THAT I HAVE SURVEYED THE ABOVE DESCRIBED PROPERTY AND THAT THE ABOVE MAP IS A TRUE REPRESENTATION THEREOF AND SHOWS THE SIZE AND LOCATION OF THE PROPERTY, ITS EXTERIOR BOUNDARIES, THE LOCATION OF ALL VISIBLE STRUCTURES AND DIMENSIONS OF ALL PRINCIPAL BUILDINGS THEREON, BOUNDARY FENCES, APPARENT EASEMENTS, ROADWAYS AND VISIBLE ENCROACHMENTS, IF ANY, TO THE BEST OF MY KNOWLEDGE AND BELIEF.

THIS SURVEY IS MADE FOR THE USE OF THE PRESENT OWNERS OF THE PROPERTY, AND ALSO THOSE WHO PURCHASE, MORTGAGE, OR GUARANTEE THE TITLE THERETO WITHIN ONE (1) YEAR FROM DATE HEREOF.

David F. Abell

DAVID F. ABELL
WISCONSIN REGISTERED LAND SURVEYOR, S-1596

May 29, 1991

DATE JOB NUMBER - 91093
NOTE: THIS IS NOT A CERTIFIED COPY UNLESS SEALED.

216-1437

FSS 00041