
ABELL SURVEYING & MAPPING

DELAVAN, WISCONSIN 53115 414-728-6737



SUTTER

AVENUE

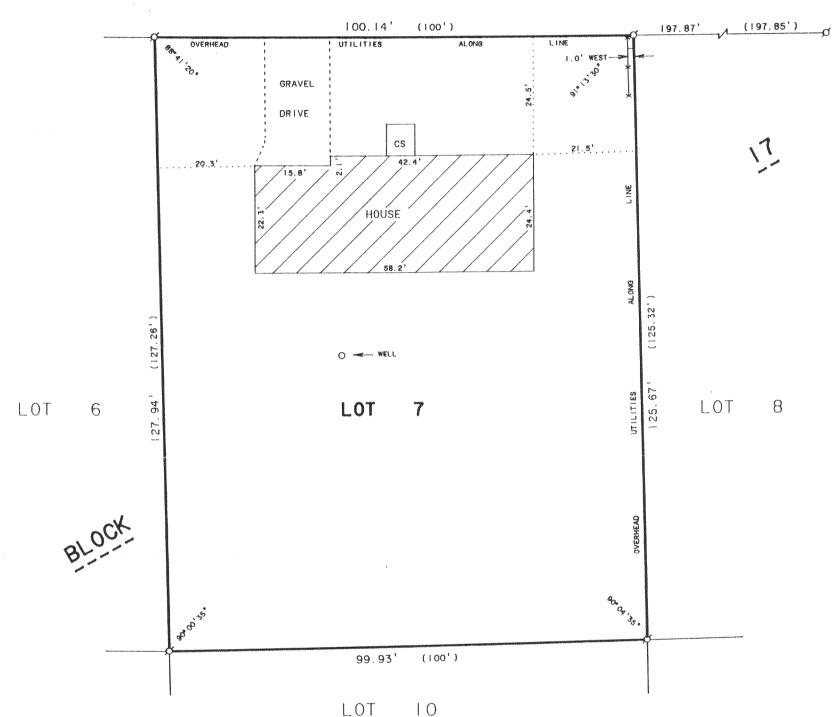

PLAT OF SURVEY OF


LOT 7. BLOCK 17. DELMAR SUBDIVISION. TZN.RIGE, WALWORTH COUNTY, WISCONSIN.

SCALE | "= 20' LEGEND

O - IRON PIPE FOUND CS - CONCRETE STOOP -X -WIRE FENCE

()-RECORDED AS

ORDERED BY: CENTURY 21-SKANDIA REALTY 312 S. 7th STREET DELAVAN, WI. 53115

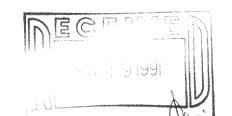

I HEREBY CERTIFY THAT I HAVE SURVEYED THE ABOVE DESCRIBED PROPERTY AND THAT THE ABOVE MAP IS A TRUE REPRESENTATION THEREOF AND SHOWS THE SIZE AND LOCATION OF THE PROPERTY, ITS EXTERIOR BOUNDARIES, THE LOCATION OF ALL VISIBLE STRUCTURES AND DIMENSIONS OF ALL PRINCIPAL BUILDINGS THEREON. BOUNDARY FENCES. APPARENT EASEMENTS, ROADWAYS AND VISIBLE ENCROACHMENTS, IF ANY, TO THE BEST OF MY KNOWLEDGE AND BELIEF.

THIS SURVEY IS MADE FOR THE USE OF THE PRESENT OWNERS OF THE PROPERTY. AND ALSO THOSE WHO PURCHASE, MORTGAGE, OR GUARANTEE THE TITLE THERETO WITHIN ONE (1) YEAR FROM DATE HEREOF.

DAVID F. ABELL

WISCONSIN REGISTERED LAND SURVEYOR, S-1596

JOB NUMBER - 91128

NOTE: THIS IS NOT A CERTIFIED COPY UNLESS SEALED.