
## ABELL SURVEYING & MAPPING

DELAVAN. WISCONSIN 53115 414-728-6737

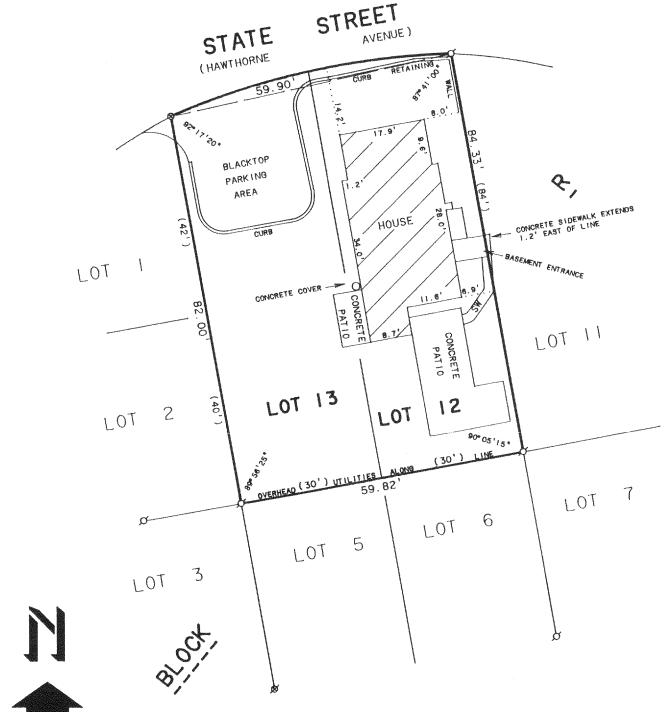

LEGEND

SCALE | "= 20'


Ø -IRON PIPE FOUND
Ø -60d NAIL FOUND
Ø -RAILROAD SPIKE SET

SW -SIDEWALK
( )-RECORDED AS

PLAT OF SURVEY OF

LOTS 12 AND 13. BLOCK "R", DELAVAN LAKE ASSEMBLY GROUNDS. T2N,R16E, WALWORTH COUNTY, WISCONSIN.

ORDERED BY: PROFESSIONAL REALTY
706 E. GENEVA ST.
DELAVAN, WI. 53115

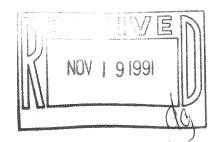

I HEREBY CERTIFY THAT I HAVE SURVEYED THE ABOVE DESCRIBED PROPERTY AND THAT THE ABOVE MAP IS A TRUE REPRESENTATION THEREOF AND SHOWS THE SIZE AND LOCATION OF THE PROPERTY, ITS EXTERIOR BOUNDARIES. THE LOCATION OF ALL VISIBLE STRUCTURES AND DIMENSIONS OF ALL PRINCIPAL BUILDINGS THEREON, BOUNDARY FENCES, APPARENT EASEMENTS, ROADWAYS AND VISIBLE ENCROACHMENTS, IF ANY, TO THE BEST OF MY KNOWLEDGE AND BELIEF.

THIS SURVEY IS MADE FOR THE USE OF THE PRESENT OWNERS OF THE PROPERTY, AND ALSO THOSE WHO PURCHASE, MORTGAGE, OR GUARANTEE THE TITLE THERETO WITHIN ONE (I) YEAR FROM POATE HEREOF.

Said 7. alel

WISCONSIN REGISTERED LAND SURVEYOR, S-1596

May 16, 1991

JOB NUMBER - 91086

NOTE: THIS IS NOT A CERTIFIED COPY UNLESS SEALED.