


DUNHAM SURVEYING, S.C.
SURVEYING & SUBDIVIDING
DELAVER, WISCONSIN 53115

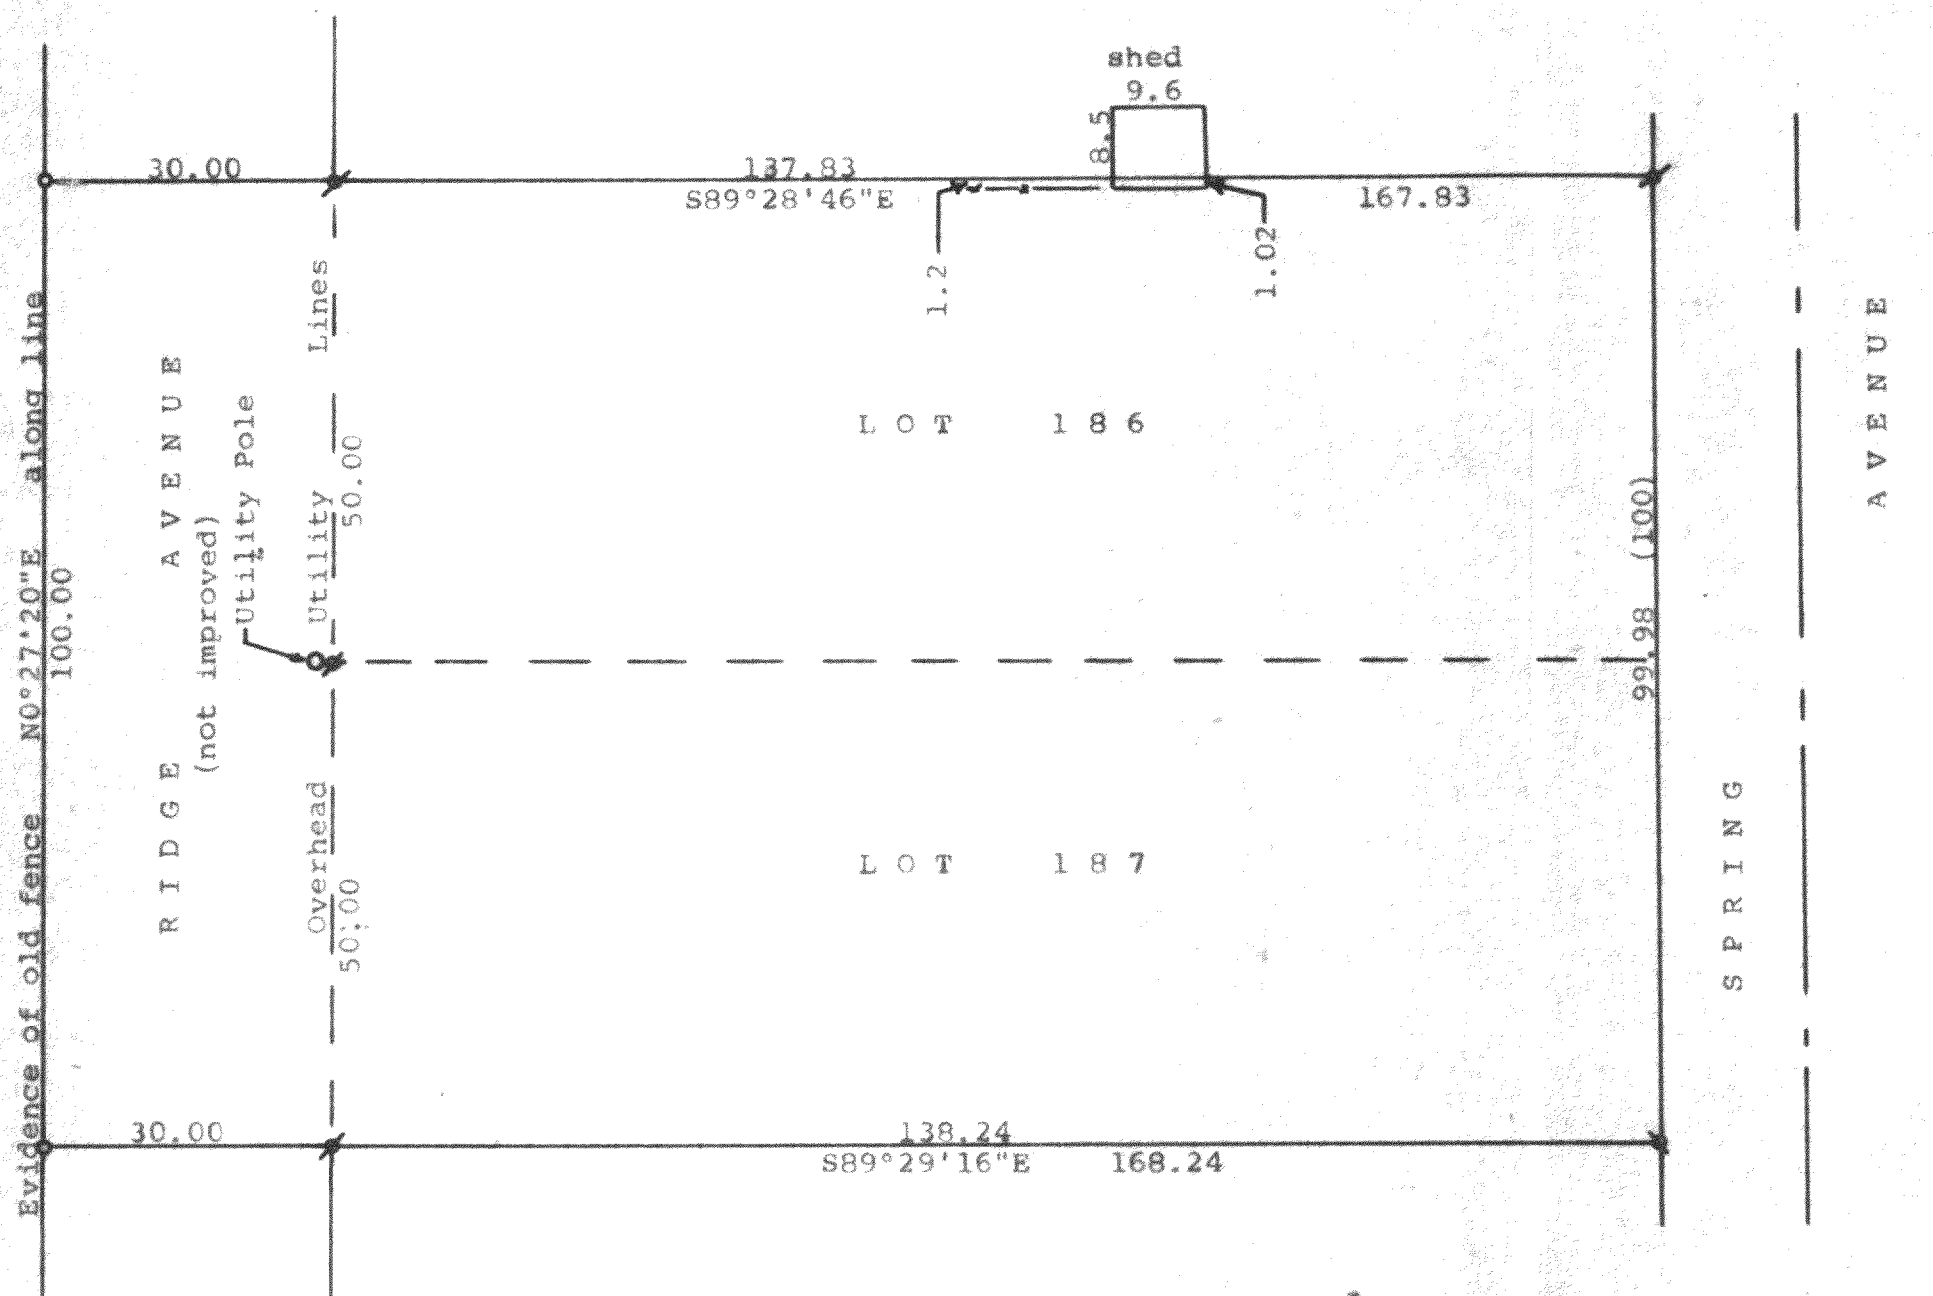

Scale - 1" = 20'

⌘ = 3/4" Iron Pipe Found

⌘ = 1 1/4" Iron Pipe Found

⊙ = 3/4" X 24" Iron Pipe Set

(0.00) = recorded distance

Bearings referenced to the recorded bearing of
NO°27'20"E along the west line of Ridge Avenue

Survey ordered by: Realty World, Carmin Realtors
811 East Geneva Street
Delavan, WI 53115

STATE OF WISCONSIN)
COUNTY OF WALWORTH) SS

I, George T. Dunham, Surveyor, certify that I have surveyed the
property described as follows:

Lots 186 and 187 in Lake Delavan Highlands, a subdivision located
in the Southeast 1/4 of Section 31, T 2 N, R 16 E, Walworth County,
Wisconsin,

and that the plat shown hereon is a correct representation thereof and shows
the size and location of the property, its exterior boundaries, the location
of all visible structures and dimensions of all principal buildings thereon,
boundary fences, apparent easements, roadways and visible encroachments, if
any, and that I have surveyed the property hereon described, according to the
official records, to the best of my knowledge and belief.

November 14, 1990

George T. Dunham
George T. Dunham, Surveyor

