
DUNHAM SURVEYING, S.C. SURVEYING & SUBDIVIDING DELAYAN, WISCONSIN 53115

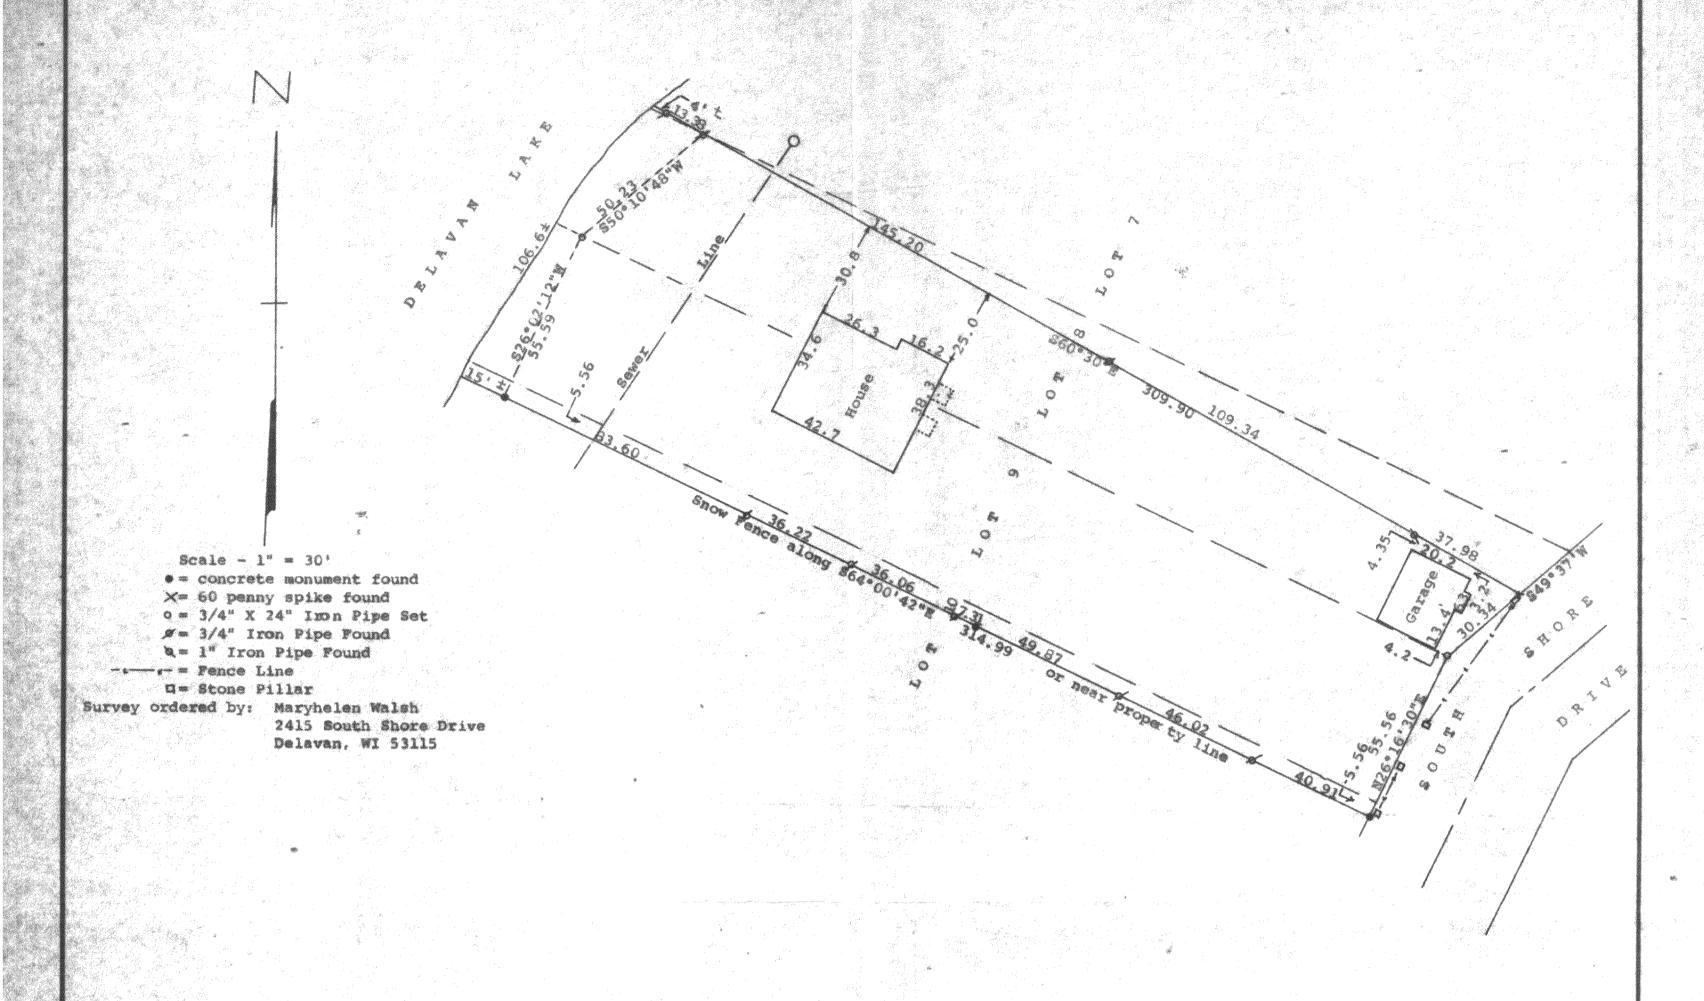

STATE OF WISCONSIN) SS

COUNTY OF WALWORTH)

I, George T. Dunham, Surveyor, certify that I have surveyed the property described as follows:

A part of Lots 7, 8, 9, and 10 of Bailey Subdivision located in the West Fractional 1 of Section 27, T 2 N, R 16 E, Walworth County, Wisconsin, described as follows: Beginning on the easterly line of said Lot 10 at a point located 5.56 feet southwesterly of the most easterly corner of said Lot 10; thence northeasterly along the easterly line of said Lots 10, 9, and 8, 85.90 feet; thence northwesterly 292.62 feet to an iron pipe located on the base line of said Bailey Subdivision on the corner of said Lots 7 and 8; thence continue on the same course 15.0 feet more or less to the shore of Delavan Lake; thence southwesterly along the shore of Delavan Lake 106.6 feet more or less to a point located 5.56 feet southwesterly of the most northerly corner of said Lot 10; thence southeasterly parallel with and 5.56 feet southwest of the northeasterly line of said Lot 10, 314.99 feet to the place of beginning.

and that the plat shown hereon is a correct representation thereof and shows the size and location of the property, its exterior boundaries, the location of all visible structures and dimensions of all principal buildings thereon, boundary fences, apparent easements, roadways and visible encroachments, if any, and that I have surveyed the property hereon described, according to the official records, to the best of my knowledge and belief.


August 15, 1990

George M. Dunham, Surveyor





DUNHAM SURVEYING, S. C. SURVEYING & SUBDIVIDING DELAVAN, WISCONSIN 53115

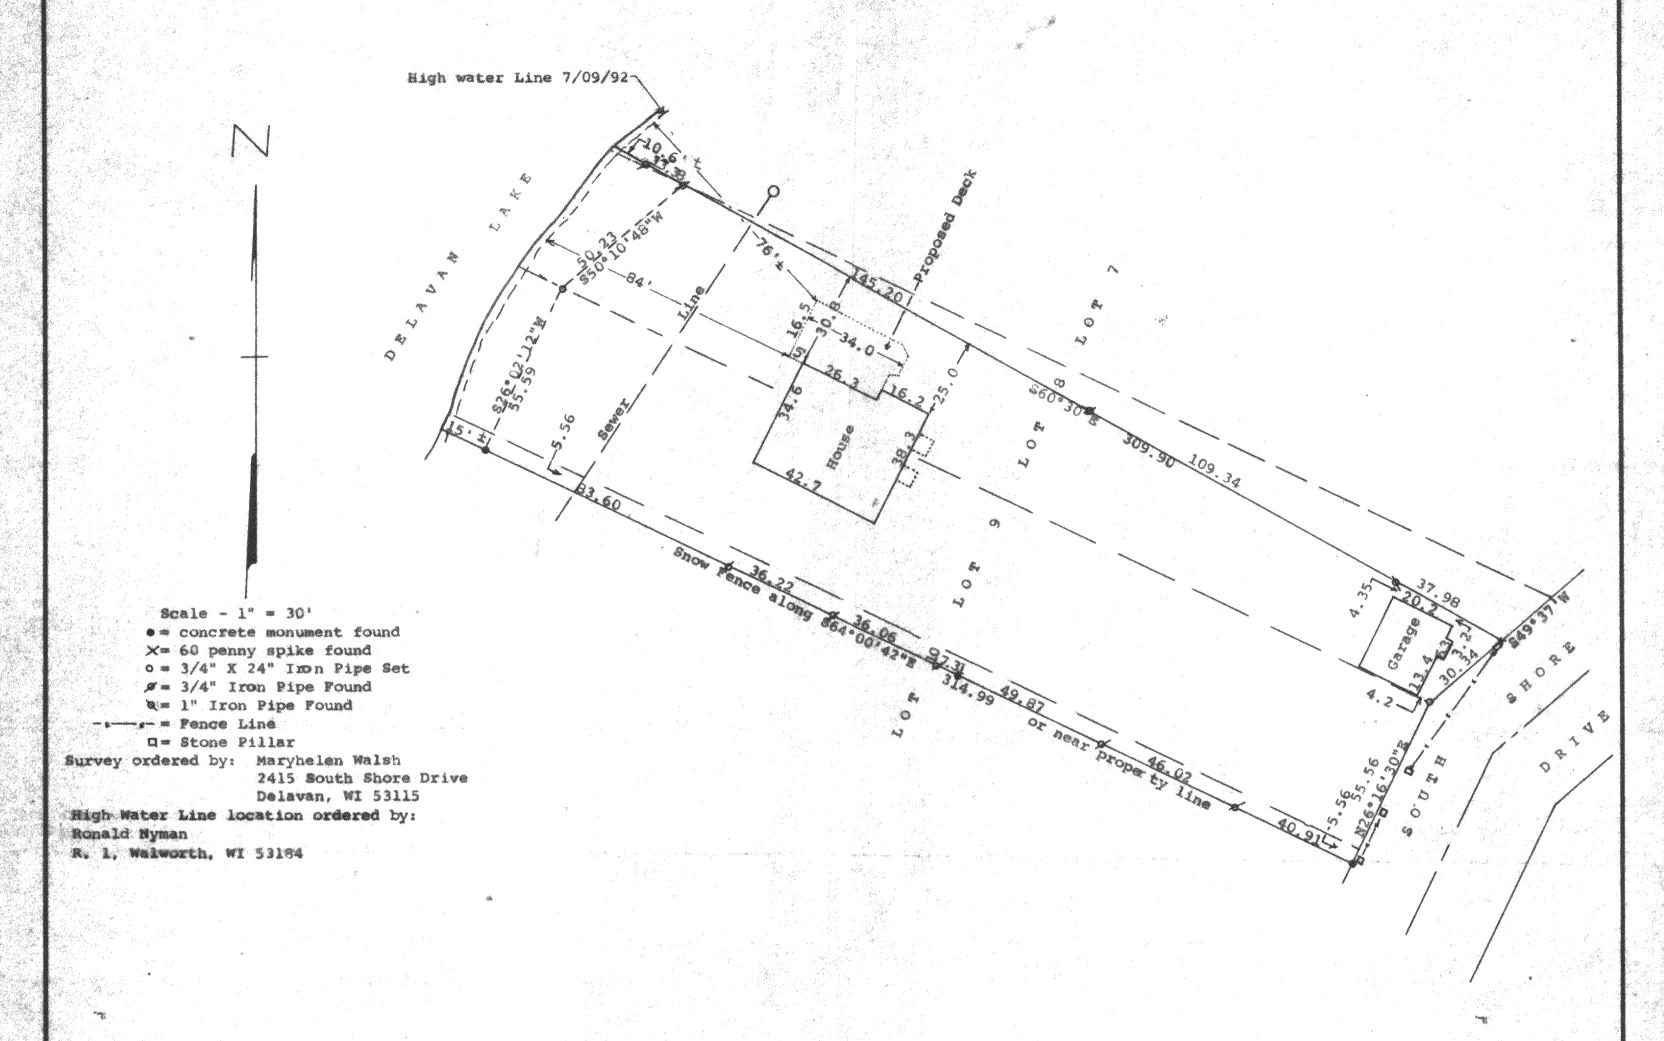

STATE OF WISCONSIN) SS

COUNTY OF WALMORTH)

I, George T. Dunham, Surveyor, certify that I have surveyed the property described as follows:

A part of Lots 7, 8, 9, and 10 of Bailey Subdivision located in the West Fractional 5 of Section 27, T 2 N, R 16 E, Walworth County, Wisconsin, described as follows: Beginning on the easterly line of said Lot 10 at a point located 5.56 feet southwesterly of the most easterly corner of said Lot 10; thence northeasterly along the easterly line of said Lots 10, 9, and 8, 85.90 feet; thence northwesterly 292.62 feet to an iron pipe located on the base line of said Bailey subdivision on the corner of said Lots 7 and 8; thence continue on the same course 15.0 feet more or less to the shore of Delavan Lake; thence southwesterly along the shore of Delavan Lake 106.6 feet more or less to a point located 5.56 feet southwesterly of the most mortherly corner of said Lot 10; thence southeasterly parallel with and 5.56 feet southwest of the northeasterly line of said Lot 10, 314.99 feet to the place of beginning.

and that the plat shown hereon is a correct representation thereof and shows the size and location of the property, its exterior boundaries, the location of all visible structures and dimensions of all principal buildings thereon, boundary fences, apparent easements, roadways and visible encroachments, if any, and that I have surveyed the property hereon described, according to the official records, to the best of my knowledge and belief.

August 15, 1990 Revised July 9, 1992 to show High Water Line and proposed deck

George M. Dunham, Surveyor

