


DUNHAM SURVEYING, S. C.
SURVEYING & SUBDIVIDING
DELAVAN, WISCONSIN 53115

N

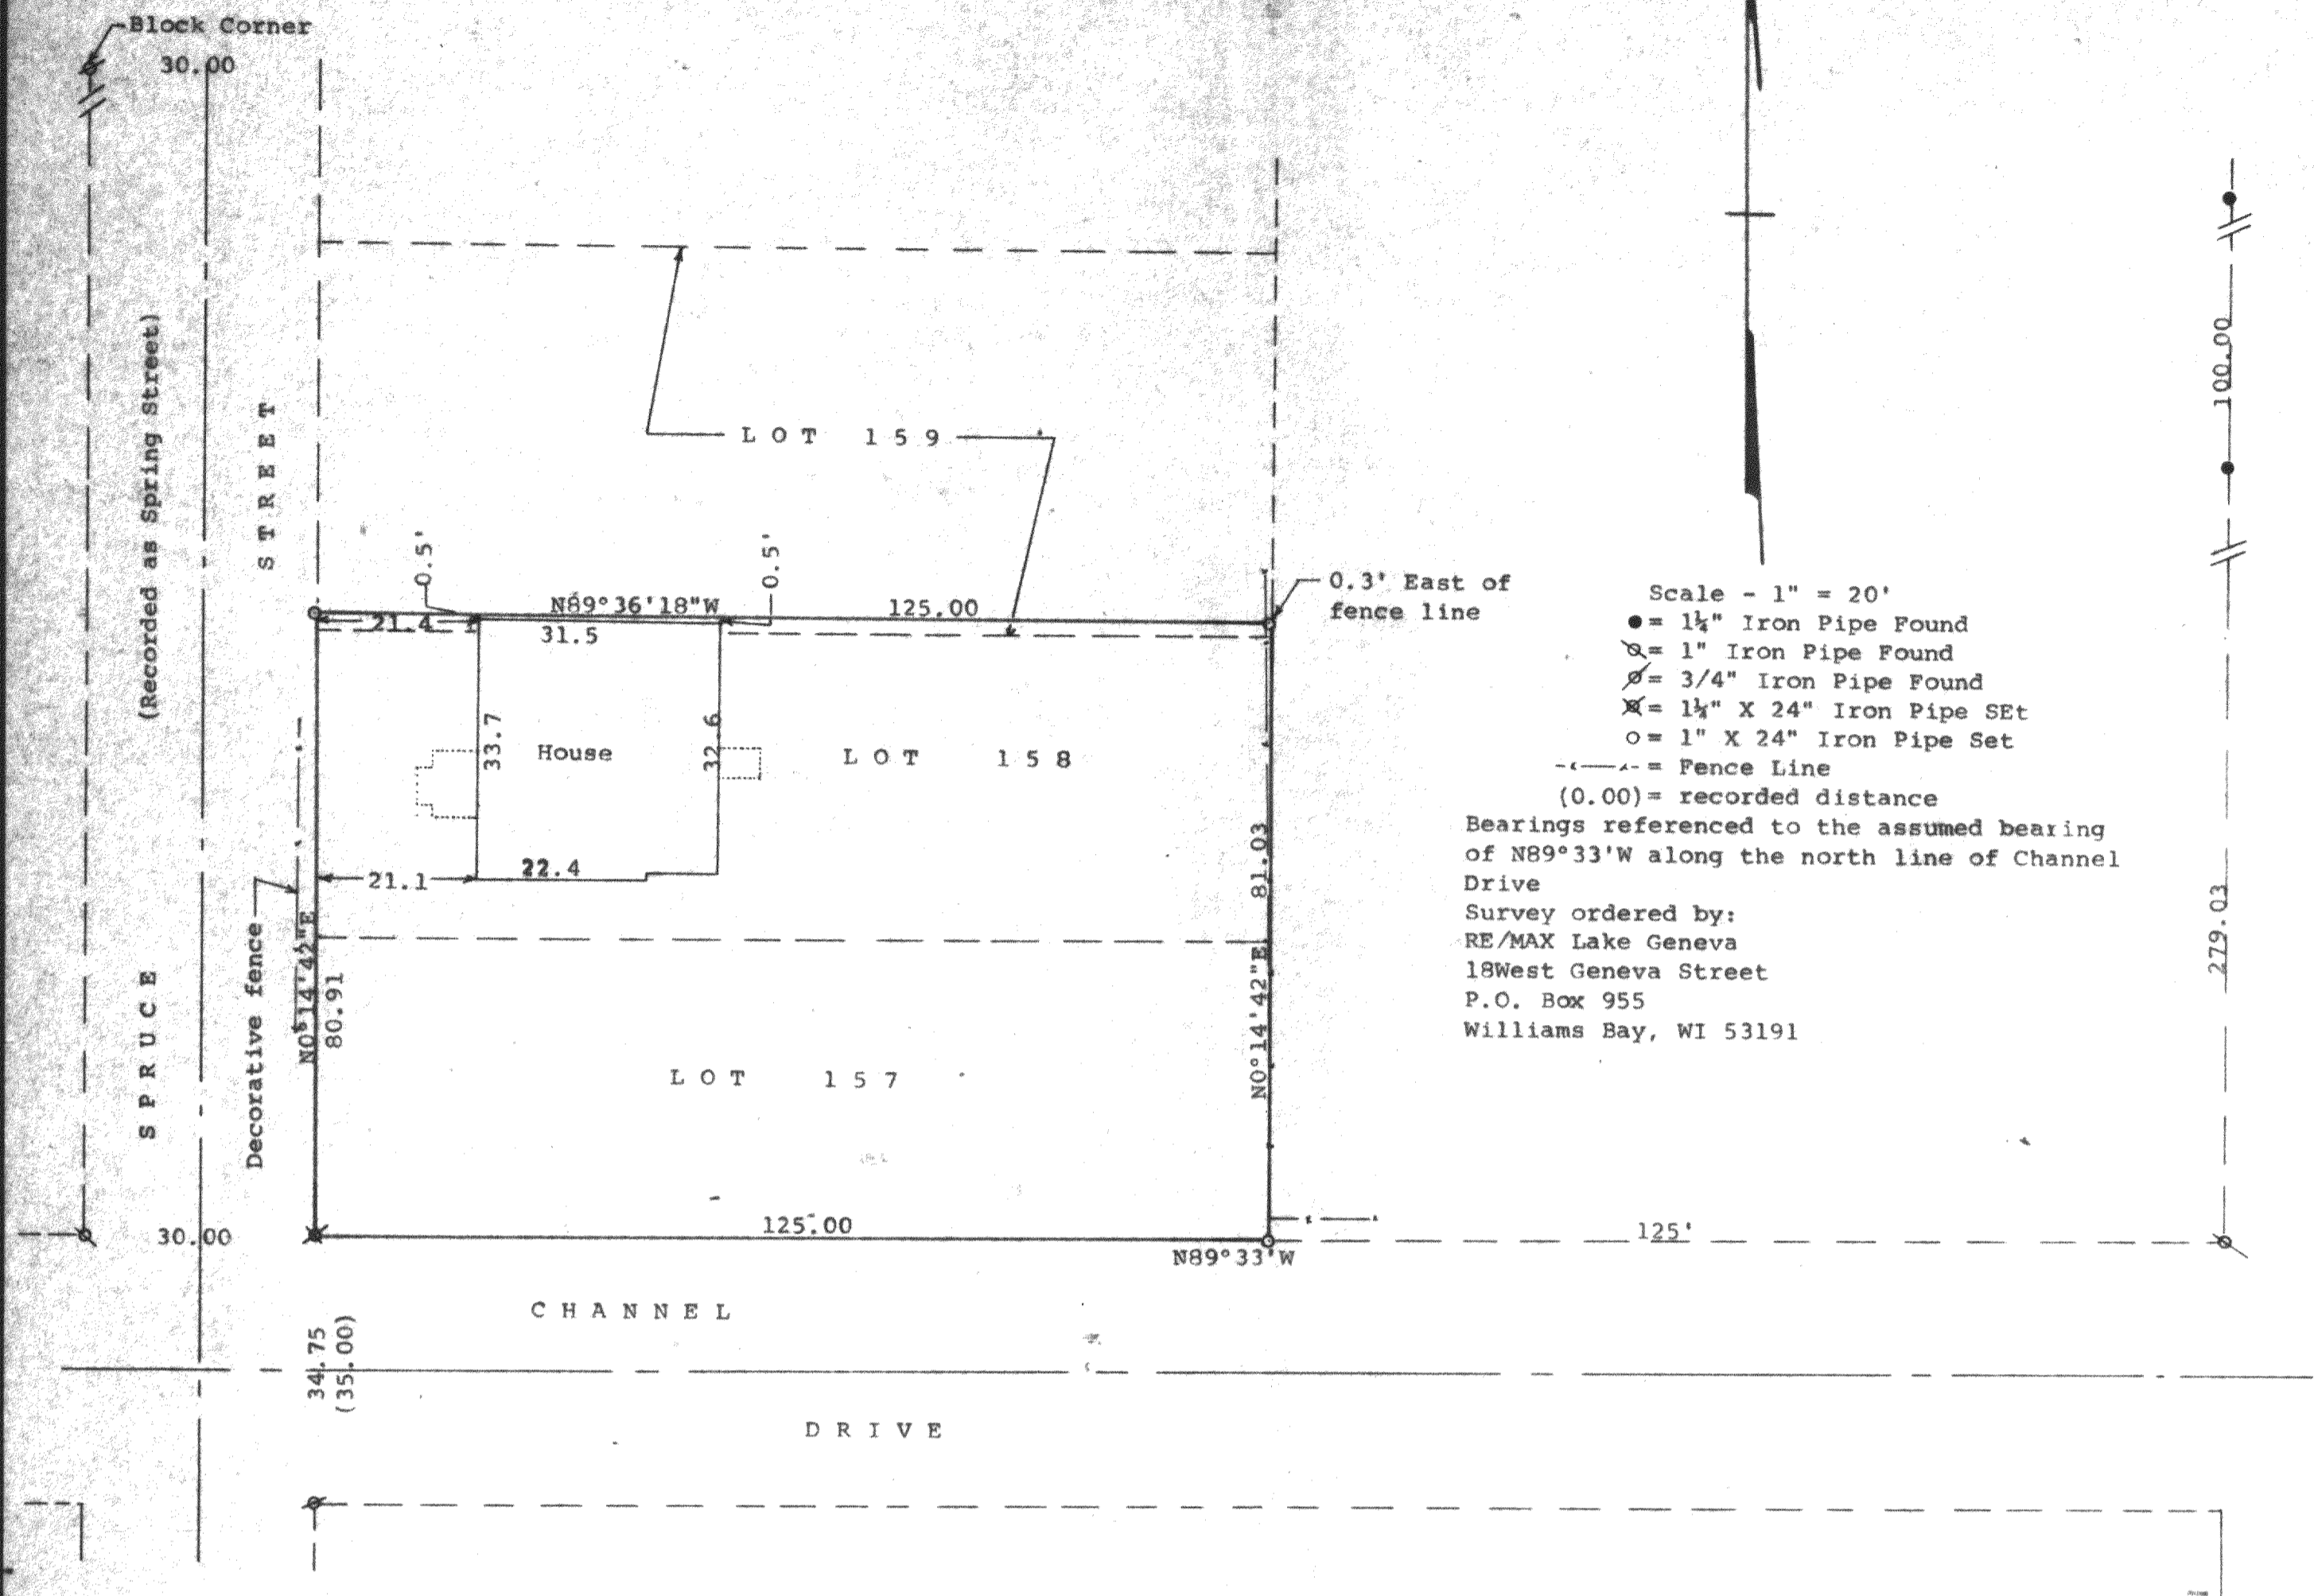

Scale - 1" = 20'

- = 1 1/4" Iron Pipe Found
- ⊗ = 1" Iron Pipe Found
- ⊘ = 3/4" Iron Pipe Found
- ⊗ = 1 1/4" X 24" Iron Pipe Set
- = 1" X 24" Iron Pipe Set
- - - = Fence Line
- (0.00) = recorded distance

Bearings referenced to the assumed bearing of N89°33'W along the north line of Channel Drive

Survey ordered by:
RE/MAX Lake Geneva
18 West Geneva Street
P.O. Box 955
Williams Bay, WI 53191

STATE OF WISCONSIN)SS
COUNTY OF WALWORTH)

I, George T. Dunham, Surveyor, certify that I have surveyed the property described as follows:

Lot 157, 158 and the South 2 feet of Lot 159, Lake Delavan Highlands, a subdivision located in Section 31, T 2 N, R 16 E, Walworth County, Wisconsin,

and that the plat shown hereon is a correct representation thereof and shows the size and location of the property, its exterior boundaries, the location of all visible structures and dimensions of all principal buildings thereon, boundary fences, apparent easements, roadways and visible encroachments, if any, and that I have surveyed the property hereon described, according to the official records, to the best of my knowledge and belief.

June 5, 1991

George T. Dunham
George T. Dunham, Surveyor

