
DUNHAM SURVEYING, S.C. SURVEYING & SUBDIVIDING DELAVAN, WISCONSIN 53115

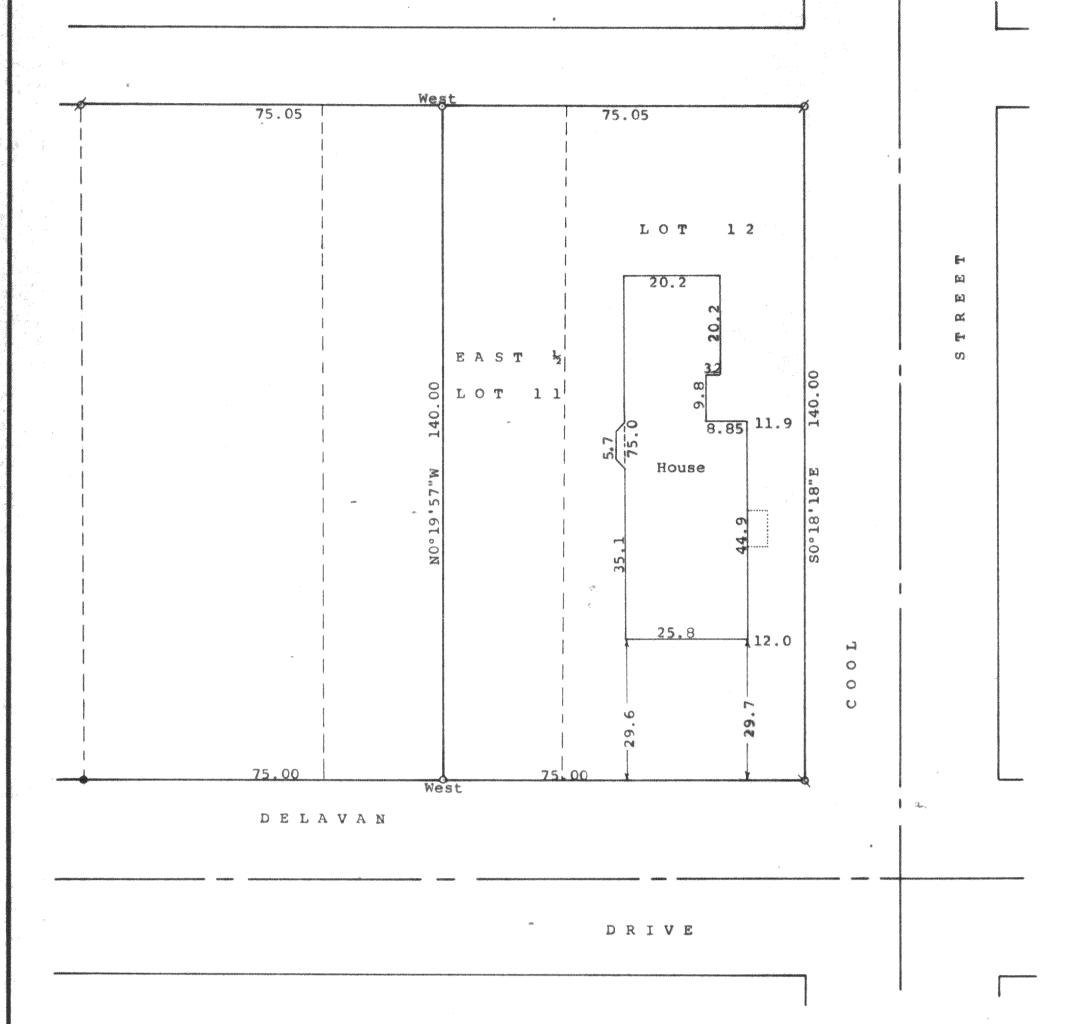

Scale - 1" = 20' $\emptyset = 3/4$ " Iron Pipe Found Q = 1" Iron Pipe Found • = 14" Iron Pipe Found O = 1" X 24" Iron Pipe Set Bearings referenced to the north line of Delavan Drive with the assumed bearing of West. Survey ordered by: Jeff Boness 325 Cool Street Delavan, WI 53115

STATE OF WISCONSIN) SS COUNTY OF WALWORTH)

I. George T. Dunham, Surveyor, certify that I have surveyed the property

described as follows:

The East 1 of Lot 11 and all of Lot 12, Block 2 of Inlet Oaks Subdivision No. 4, located in Section 15, T 2 N, R 16 E, Walworth County, Wisconsin, and that the plat shown hereon is a correct representation thereof and shows the size and location of the property, its exterior boundaries, the location of all visible structures and dimensions of all principal buildings thereon, boundary fences, apparent easements, roadways and visible encroachments, if any, and that I have surveyed the property hereon described, according to the official records, to the best of my knowledge and belief. December 23, 1991

George TO Dunham, Surveyor



