



ABELL  
SURVEYING & MAPPING  
DELANAV, WISCONSIN 53115  
414-728-6737

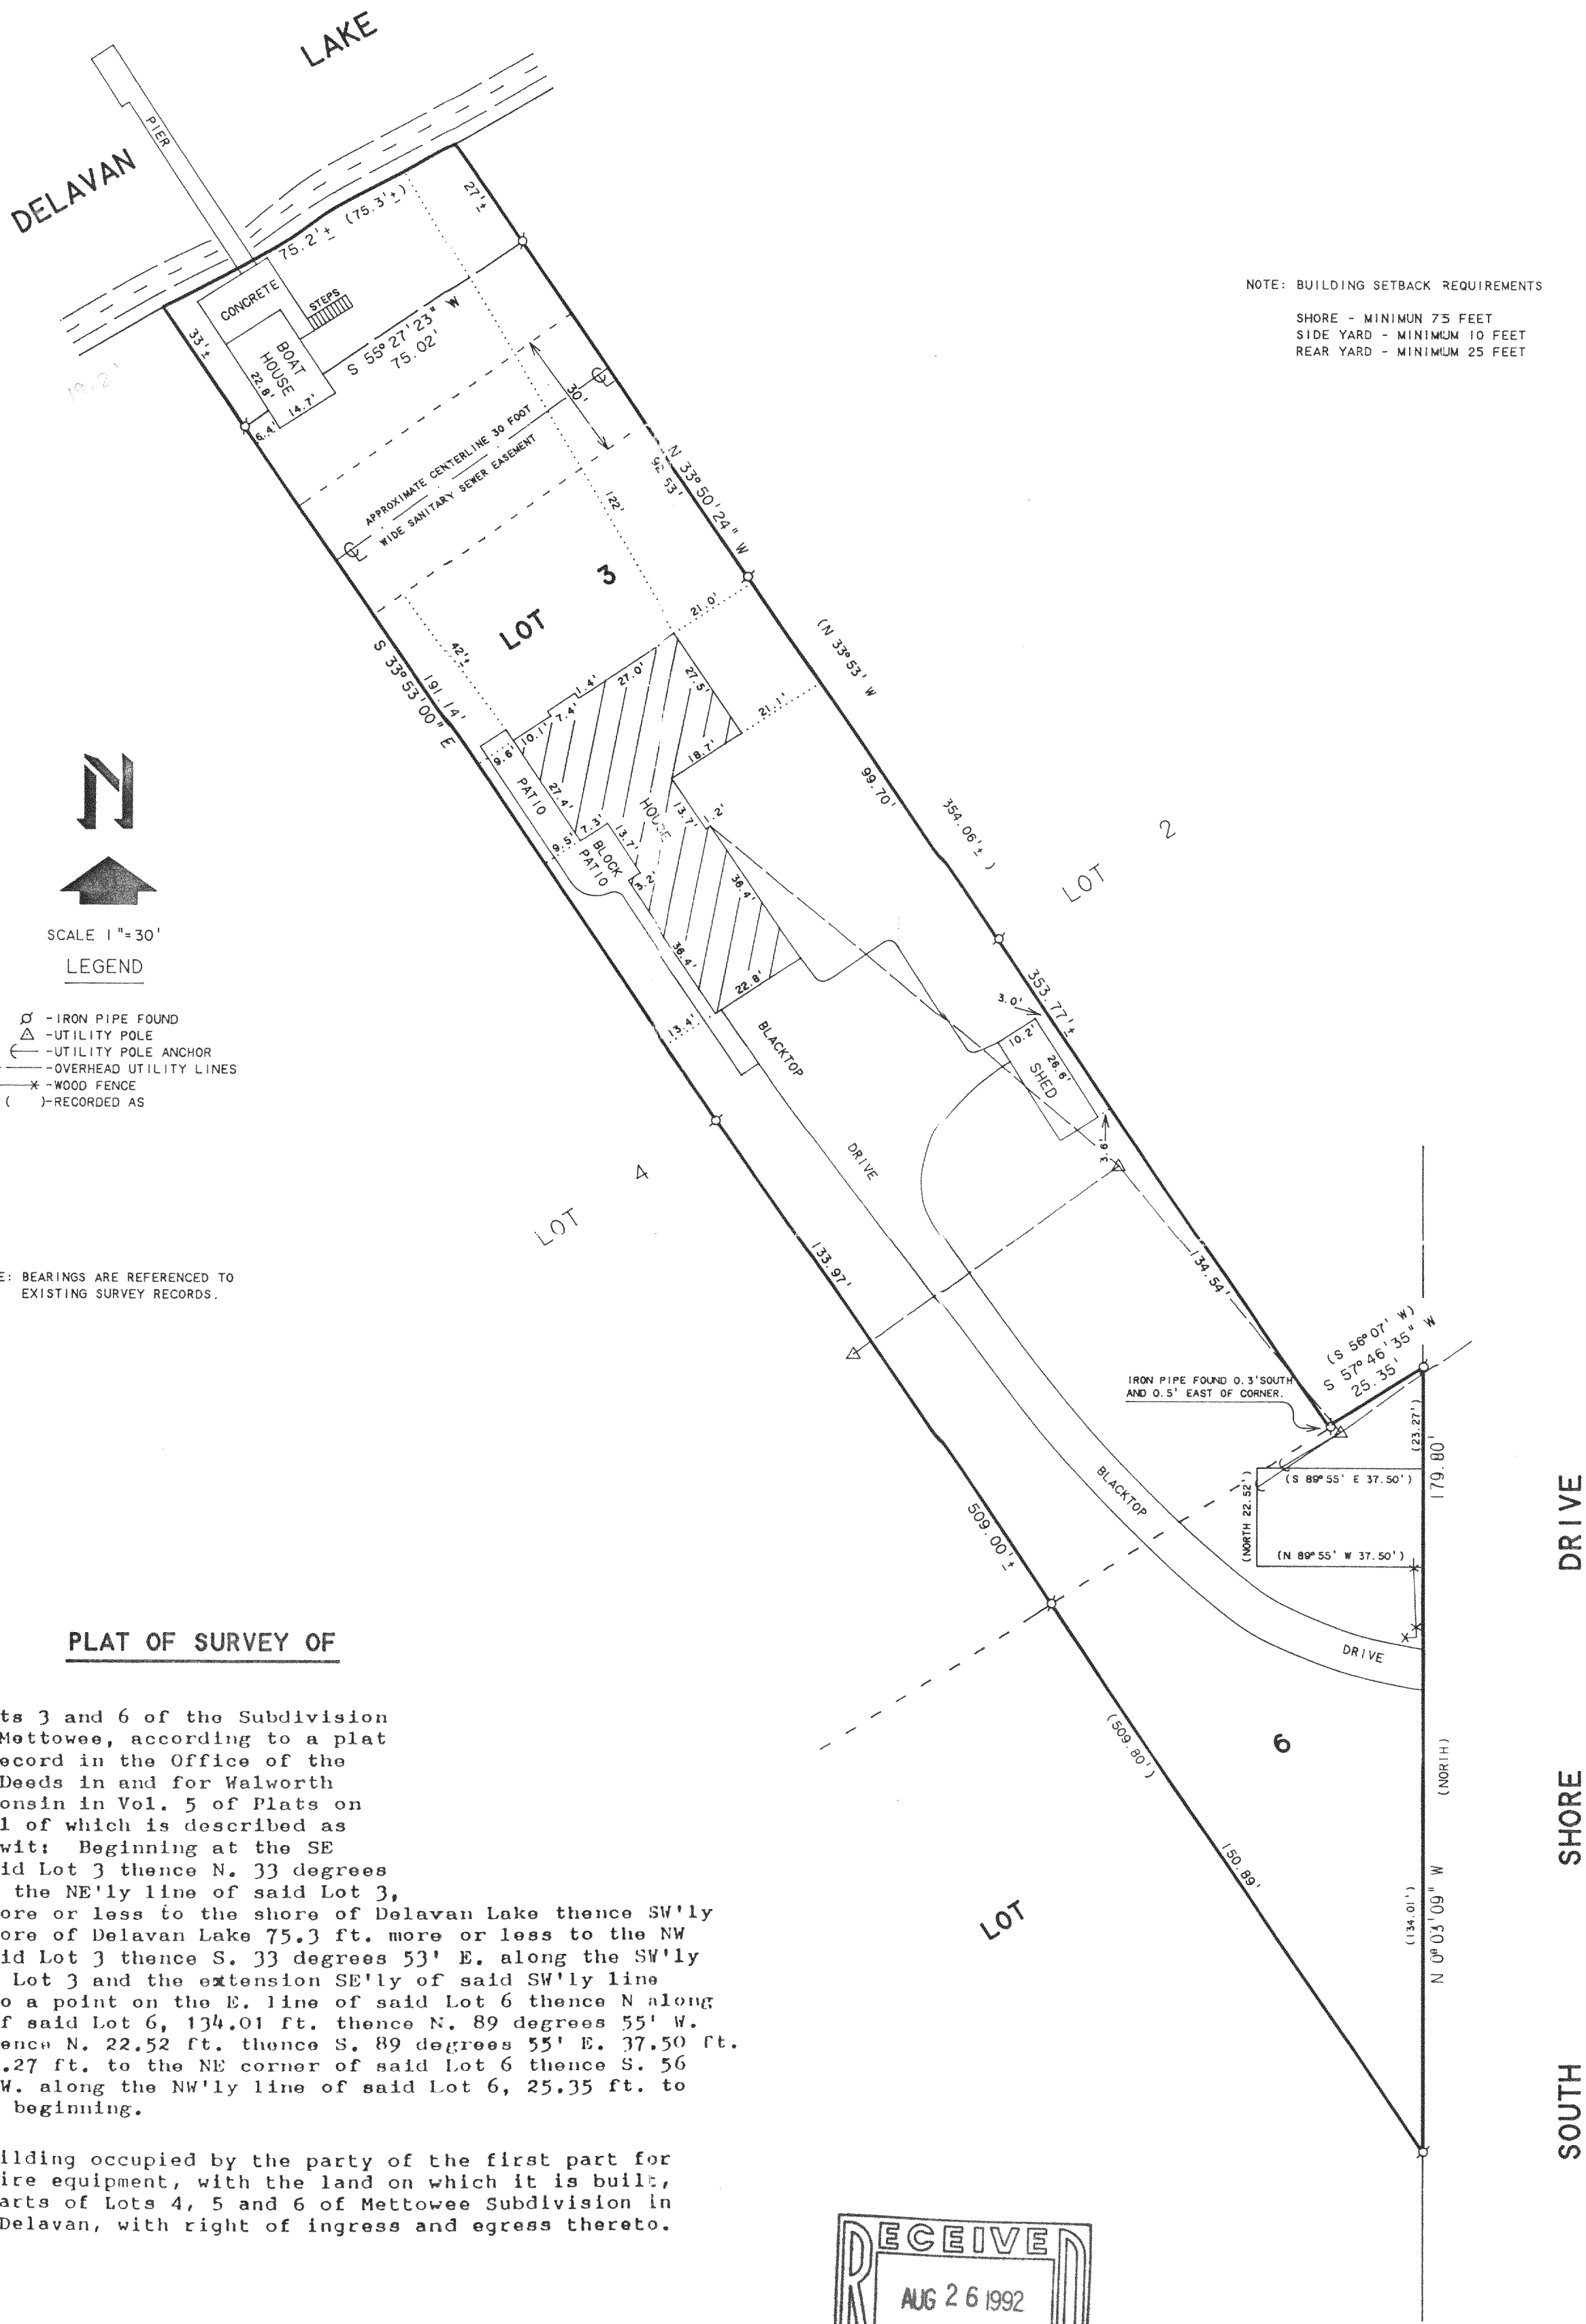

NOTE: BUILDING SETBACK REQUIREMENTS  
SHORE - MINIMUM 75 FEET  
SIDE YARD - MINIMUM 10 FEET  
REAR YARD - MINIMUM 25 FEET

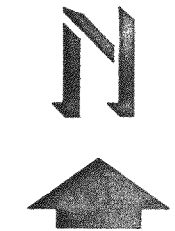

SCALE 1" = 30'

LEGEND


- - IRON PIPE FOUND
- △ - UTILITY POLE
- ◁ - UTILITY POLE ANCHOR
- - OVERHEAD UTILITY LINES
- \* - WOOD FENCE
- ( ) - RECORDED AS

NOTE: BEARINGS ARE REFERENCED TO EXISTING SURVEY RECORDS.

PLAT OF SURVEY OF

A part of Lots 3 and 6 of the Subdivision of Lot 1 of Mettowee, according to a plat thereof of record in the Office of the Register of Deeds in and for Walworth County, Wisconsin in Vol. 5 of Plats on page 242, all of which is described as follows, to-wit: Beginning at the SE corner of said Lot 3 thence N. 33 degrees 53' W. along the NE'ly line of said Lot 3, 354.06 ft. more or less to the shore of Delavan Lake thence SW'ly along the shore of Delavan Lake 75.3 ft. more or less to the NW corner of said Lot 3 thence S. 33 degrees 53' E. along the SW'ly line of said Lot 3 and the extension SE'ly of said SW'ly line 509.80 ft. to a point on the E. line of said Lot 6 thence N along the E line of said Lot 6, 134.01 ft. thence N. 89 degrees 55' W. 37.50 ft. thence N. 22.52 ft. thence S. 89 degrees 55' E. 37.50 ft. thence N. 23.27 ft. to the NE corner of said Lot 6 thence S. 56 degrees 07' W. along the NW'ly line of said Lot 6, 25.35 ft. to the place of beginning.

The frame building occupied by the party of the first part for storage of fire equipment, with the land on which it is built, located on parts of Lots 4, 5 and 6 of Mettowee Subdivision in the Town of Delavan, with right of ingress and egress thereto.

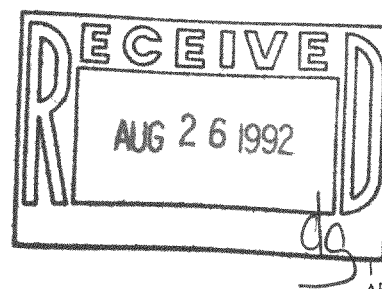

I HEREBY CERTIFY THAT I HAVE SURVEYED THE ABOVE DESCRIBED PROPERTY AND THAT THE ABOVE MAP IS A TRUE REPRESENTATION THEREOF AND SHOWS THE SIZE AND LOCATION OF THE PROPERTY, ITS EXTERIOR BOUNDARIES, THE LOCATION OF ALL VISIBLE STRUCTURES AND DIMENSIONS OF ALL PRINCIPAL BUILDINGS THEREON, BOUNDARY FENCES, APPARENT EASEMENTS, ROADWAYS AND VISIBLE ENCROACHMENTS, IF ANY, TO THE BEST OF MY KNOWLEDGE AND BELIEF.

THIS SURVEY IS MADE FOR THE USE OF THE PRESENT OWNERS OF THE PROPERTY, AND ALSO THOSE WHO PURCHASE, MORTGAGE, OR GUARANTEE THE TITLE THERETO WITHIN ONE (1) YEAR FROM THE HEREON.

*David F. Abell*  
DAVID F. ABELL  
WISCONSIN REGISTERED LAND SURVEYOR, S-1596

August 10, 1992  
DATE: \_\_\_\_\_ JOB NUMBER - 92176  
NOTE: THIS IS NOT A CERTIFIED COPY UNLESS SEALED.

ORDERED BY: THE RAULAND AGENCY  
P.O. BOX 159  
WALWORTH, WI. 53184

OWNER: JOHN JOHNSON  
2901 SOUTH SHORE DRIVE  
DELANAV, WI. 53115


216-1609

FMT1-5A

ABELL  
SURVEYING & MAPPING


DELANAV, WISCONSIN 53115

414-728-6737

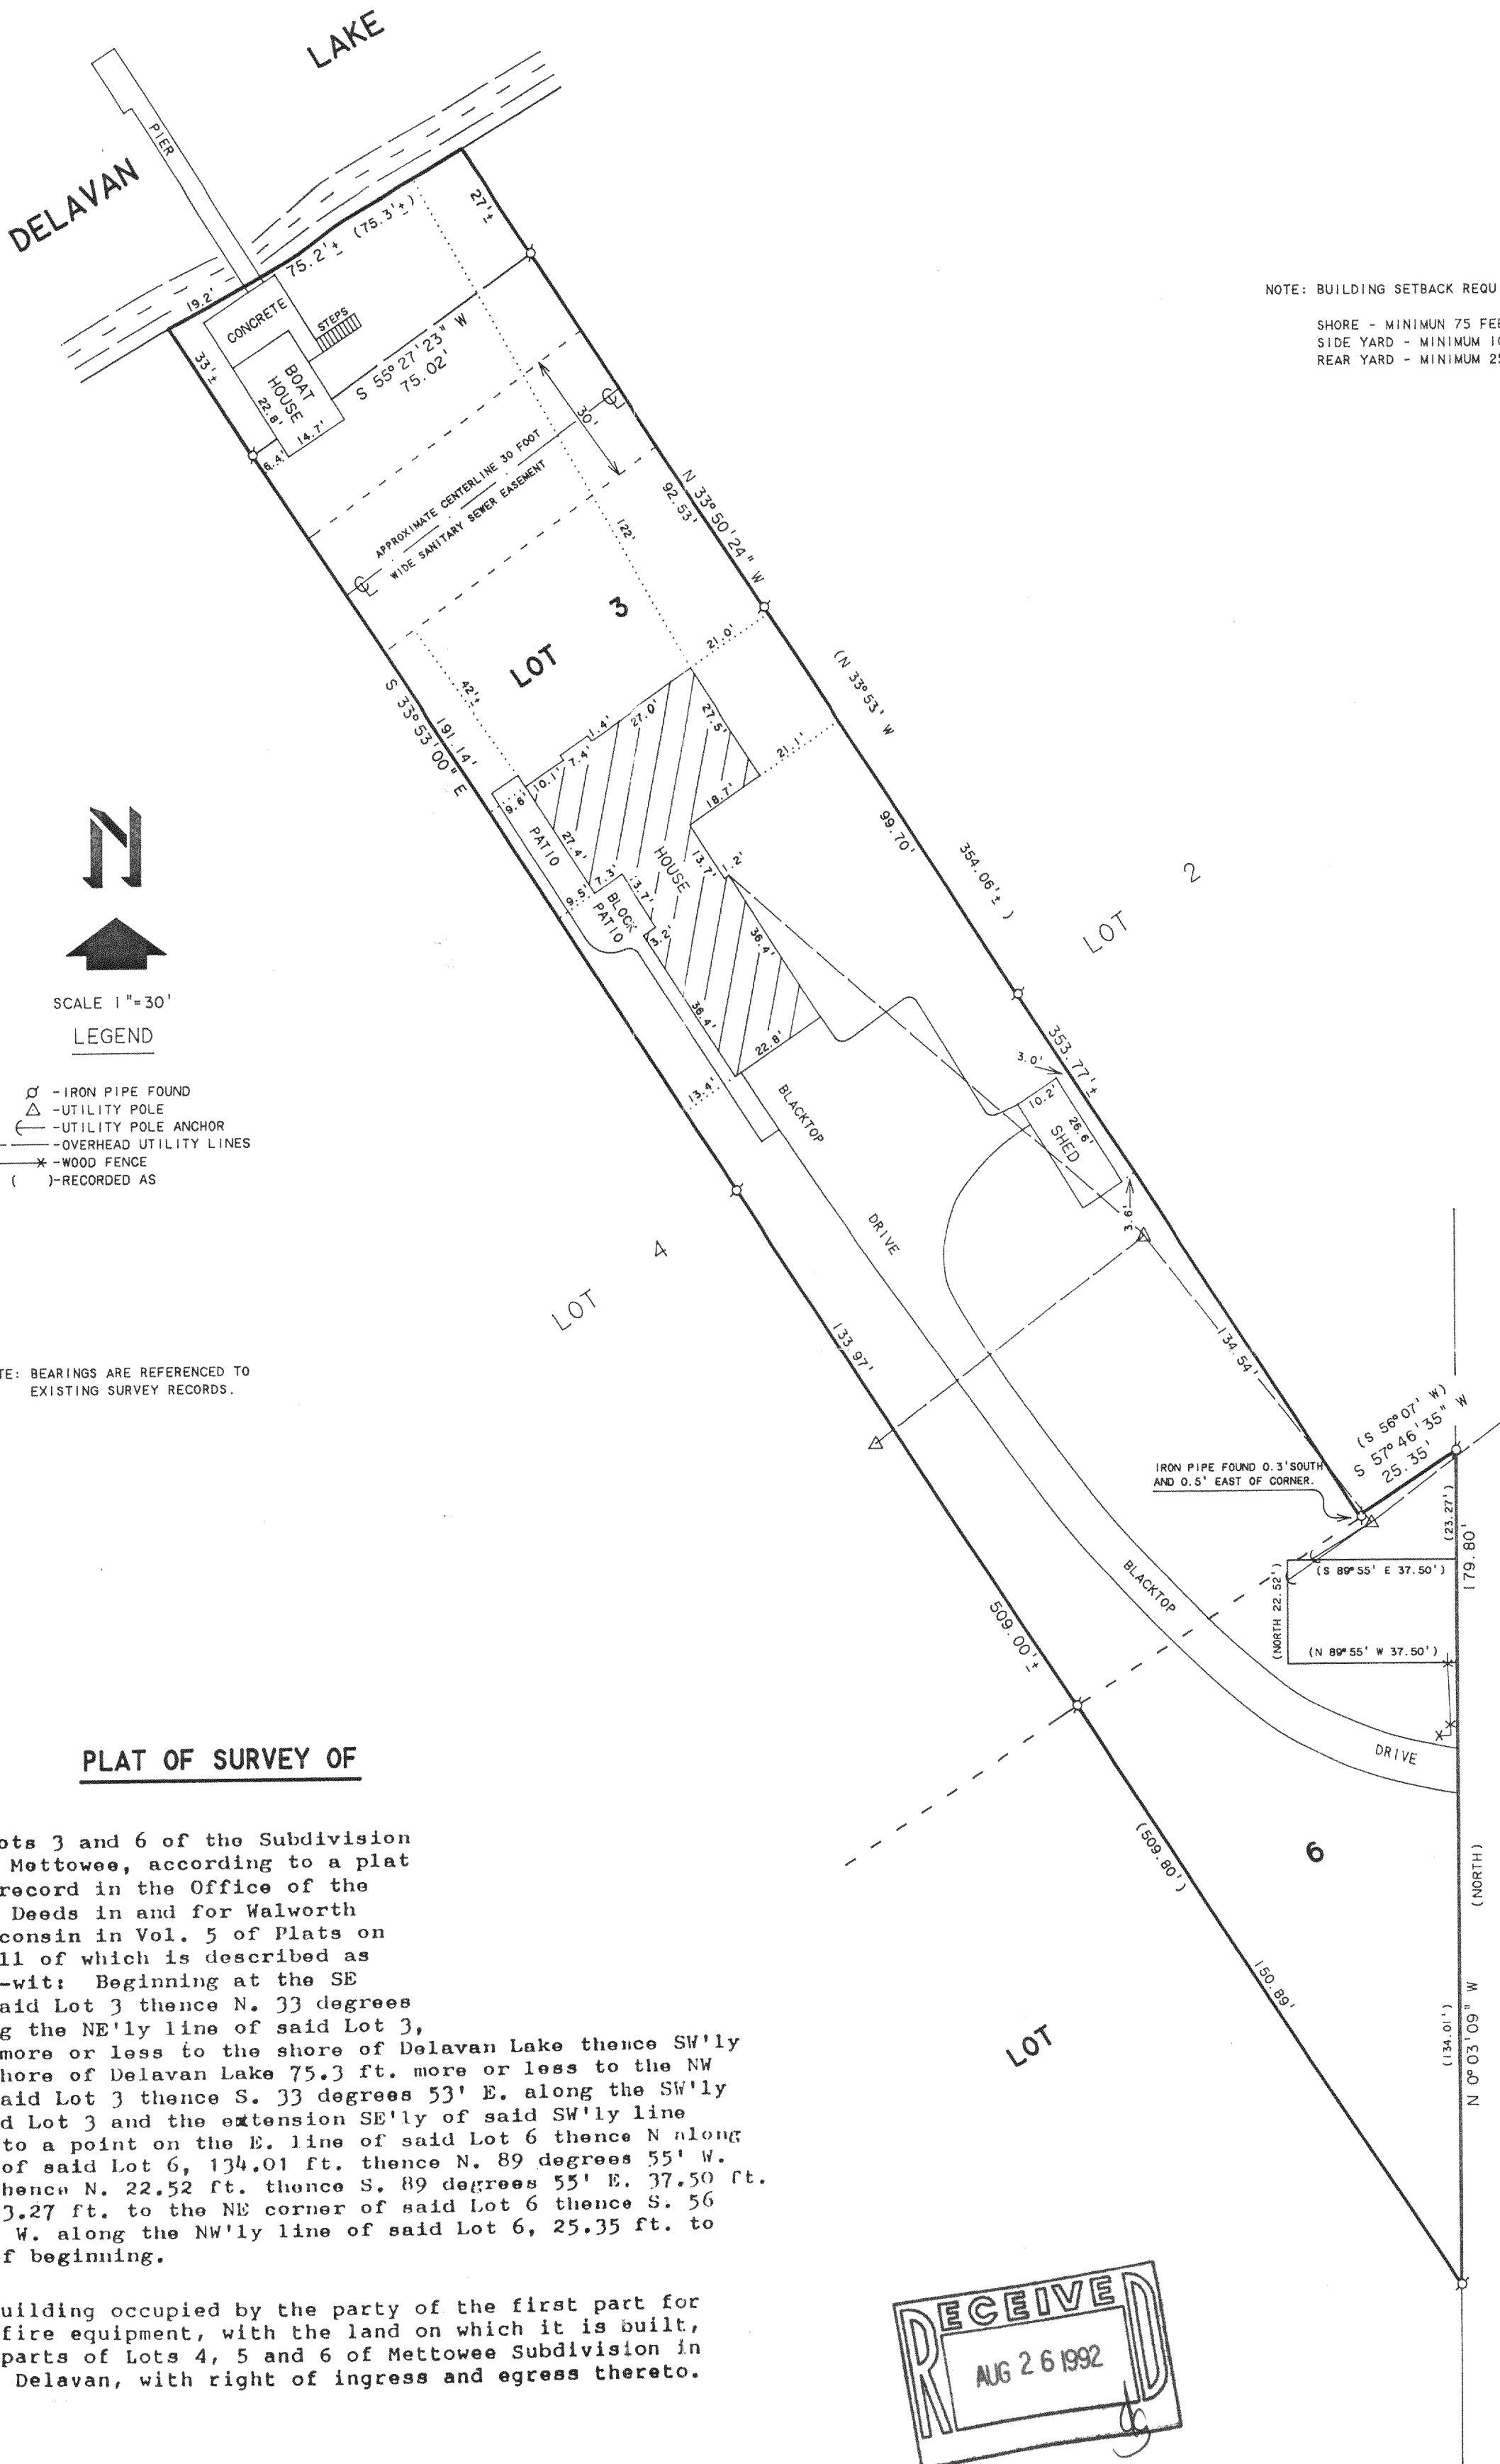

NOTE: BUILDING SETBACK REQUIREMENTS

SHORE - MINIMUM 75 FEET  
SIDE YARD - MINIMUM 10 FEET  
REAR YARD - MINIMUM 25 FEET

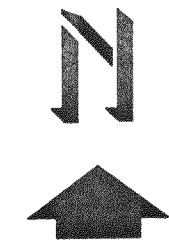

SCALE 1"=30'

LEGEND


- - IRON PIPE FOUND
- △ - UTILITY POLE
- ⊠ - UTILITY POLE ANCHOR
- - OVERHEAD UTILITY LINES
- ✕ - WOOD FENCE
- ( ) - RECORDED AS

NOTE: BEARINGS ARE REFERENCED TO EXISTING SURVEY RECORDS.

PLAT OF SURVEY OF

A part of Lots 3 and 6 of the Subdivision of Lot 1 of Mettowee, according to a plat thereof of record in the Office of the Register of Deeds in and for Walworth County, Wisconsin in Vol. 5 of Plats on page 242, all of which is described as follows, to-wit: Beginning at the SE corner of said Lot 3 thence N. 33 degrees 53' W. along the NE'y line of said Lot 3, 354.06 ft. more or less to the shore of Delavan Lake thence SW'y along the shore of Delavan Lake 75.3 ft. more or less to the NW corner of said Lot 3 thence S. 33 degrees 53' E. along the SW'y line of said Lot 3 and the extension SE'y of said SW'y line 509.80 ft. to a point on the E. line of said Lot 6 thence N along the E line of said Lot 6, 134.01 ft. thence N. 89 degrees 55' W. 37.50 ft. thence N. 22.52 ft. thence S. 89 degrees 55' E. 37.50 ft. thence N. 23.27 ft. to the NE corner of said Lot 6 thence S. 56 degrees 07' W. along the NW'y line of said Lot 6, 25.35 ft. to the place of beginning.

The frame building occupied by the party of the first part for storage of fire equipment, with the land on which it is built, located on parts of Lots 4, 5 and 6 of Mettowee Subdivision in the Town of Delavan, with right of ingress and egress thereto.

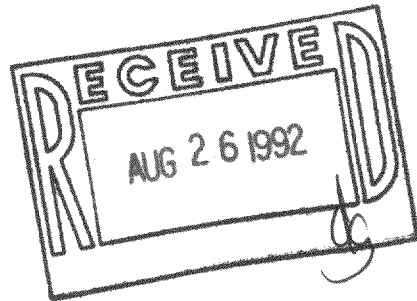

I HEREBY CERTIFY THAT I HAVE SURVEYED THE ABOVE DESCRIBED PROPERTY AND THAT THE ABOVE MAP IS A TRUE REPRESENTATION THEREOF AND SHOWS THE SIZE AND LOCATION OF THE PROPERTY, ITS EXTERIOR BOUNDARIES, THE LOCATION OF ALL VISIBLE STRUCTURES AND DIMENSIONS OF ALL PRINCIPAL BUILDINGS THEREON, BOUNDARY FENCES, APPARENT EASEMENTS, ROADWAYS AND VISIBLE ENCROACHMENTS, IF ANY, TO THE BEST OF MY KNOWLEDGE AND BELIEF.

THIS SURVEY IS MADE FOR THE USE OF THE PRESENT OWNERS OF THE PROPERTY, AND ALSO THOSE WHO PURCHASE, MORTGAGE, OR GUARANTEE THE TITLE THERETO WITHIN ONE (1) YEAR FROM DATE HEREON.

*David F. Abell*  
DAVID F. ABELL  
WISCONSIN REGISTERED LAND SURVEYOR. S-1596

August 10, 1992 REVISED - 8/14/92  
DATE JOB NUMBER - 92176  
NOTE: THIS IS NOT A CERTIFIED COPY UNLESS SEALED.


ORDERED BY: THE RAULAND AGENCY  
P.O. BOX 159  
WALWORTH, WI. 53184

OWNER: JOHN JOHNSON  
2901 SOUTH SHORE DRIVE  
DELANAV, WI. 53115

ABELL  
SURVEYING & MAPPING


DELANAV, WISCONSIN 53115

414-728-6737

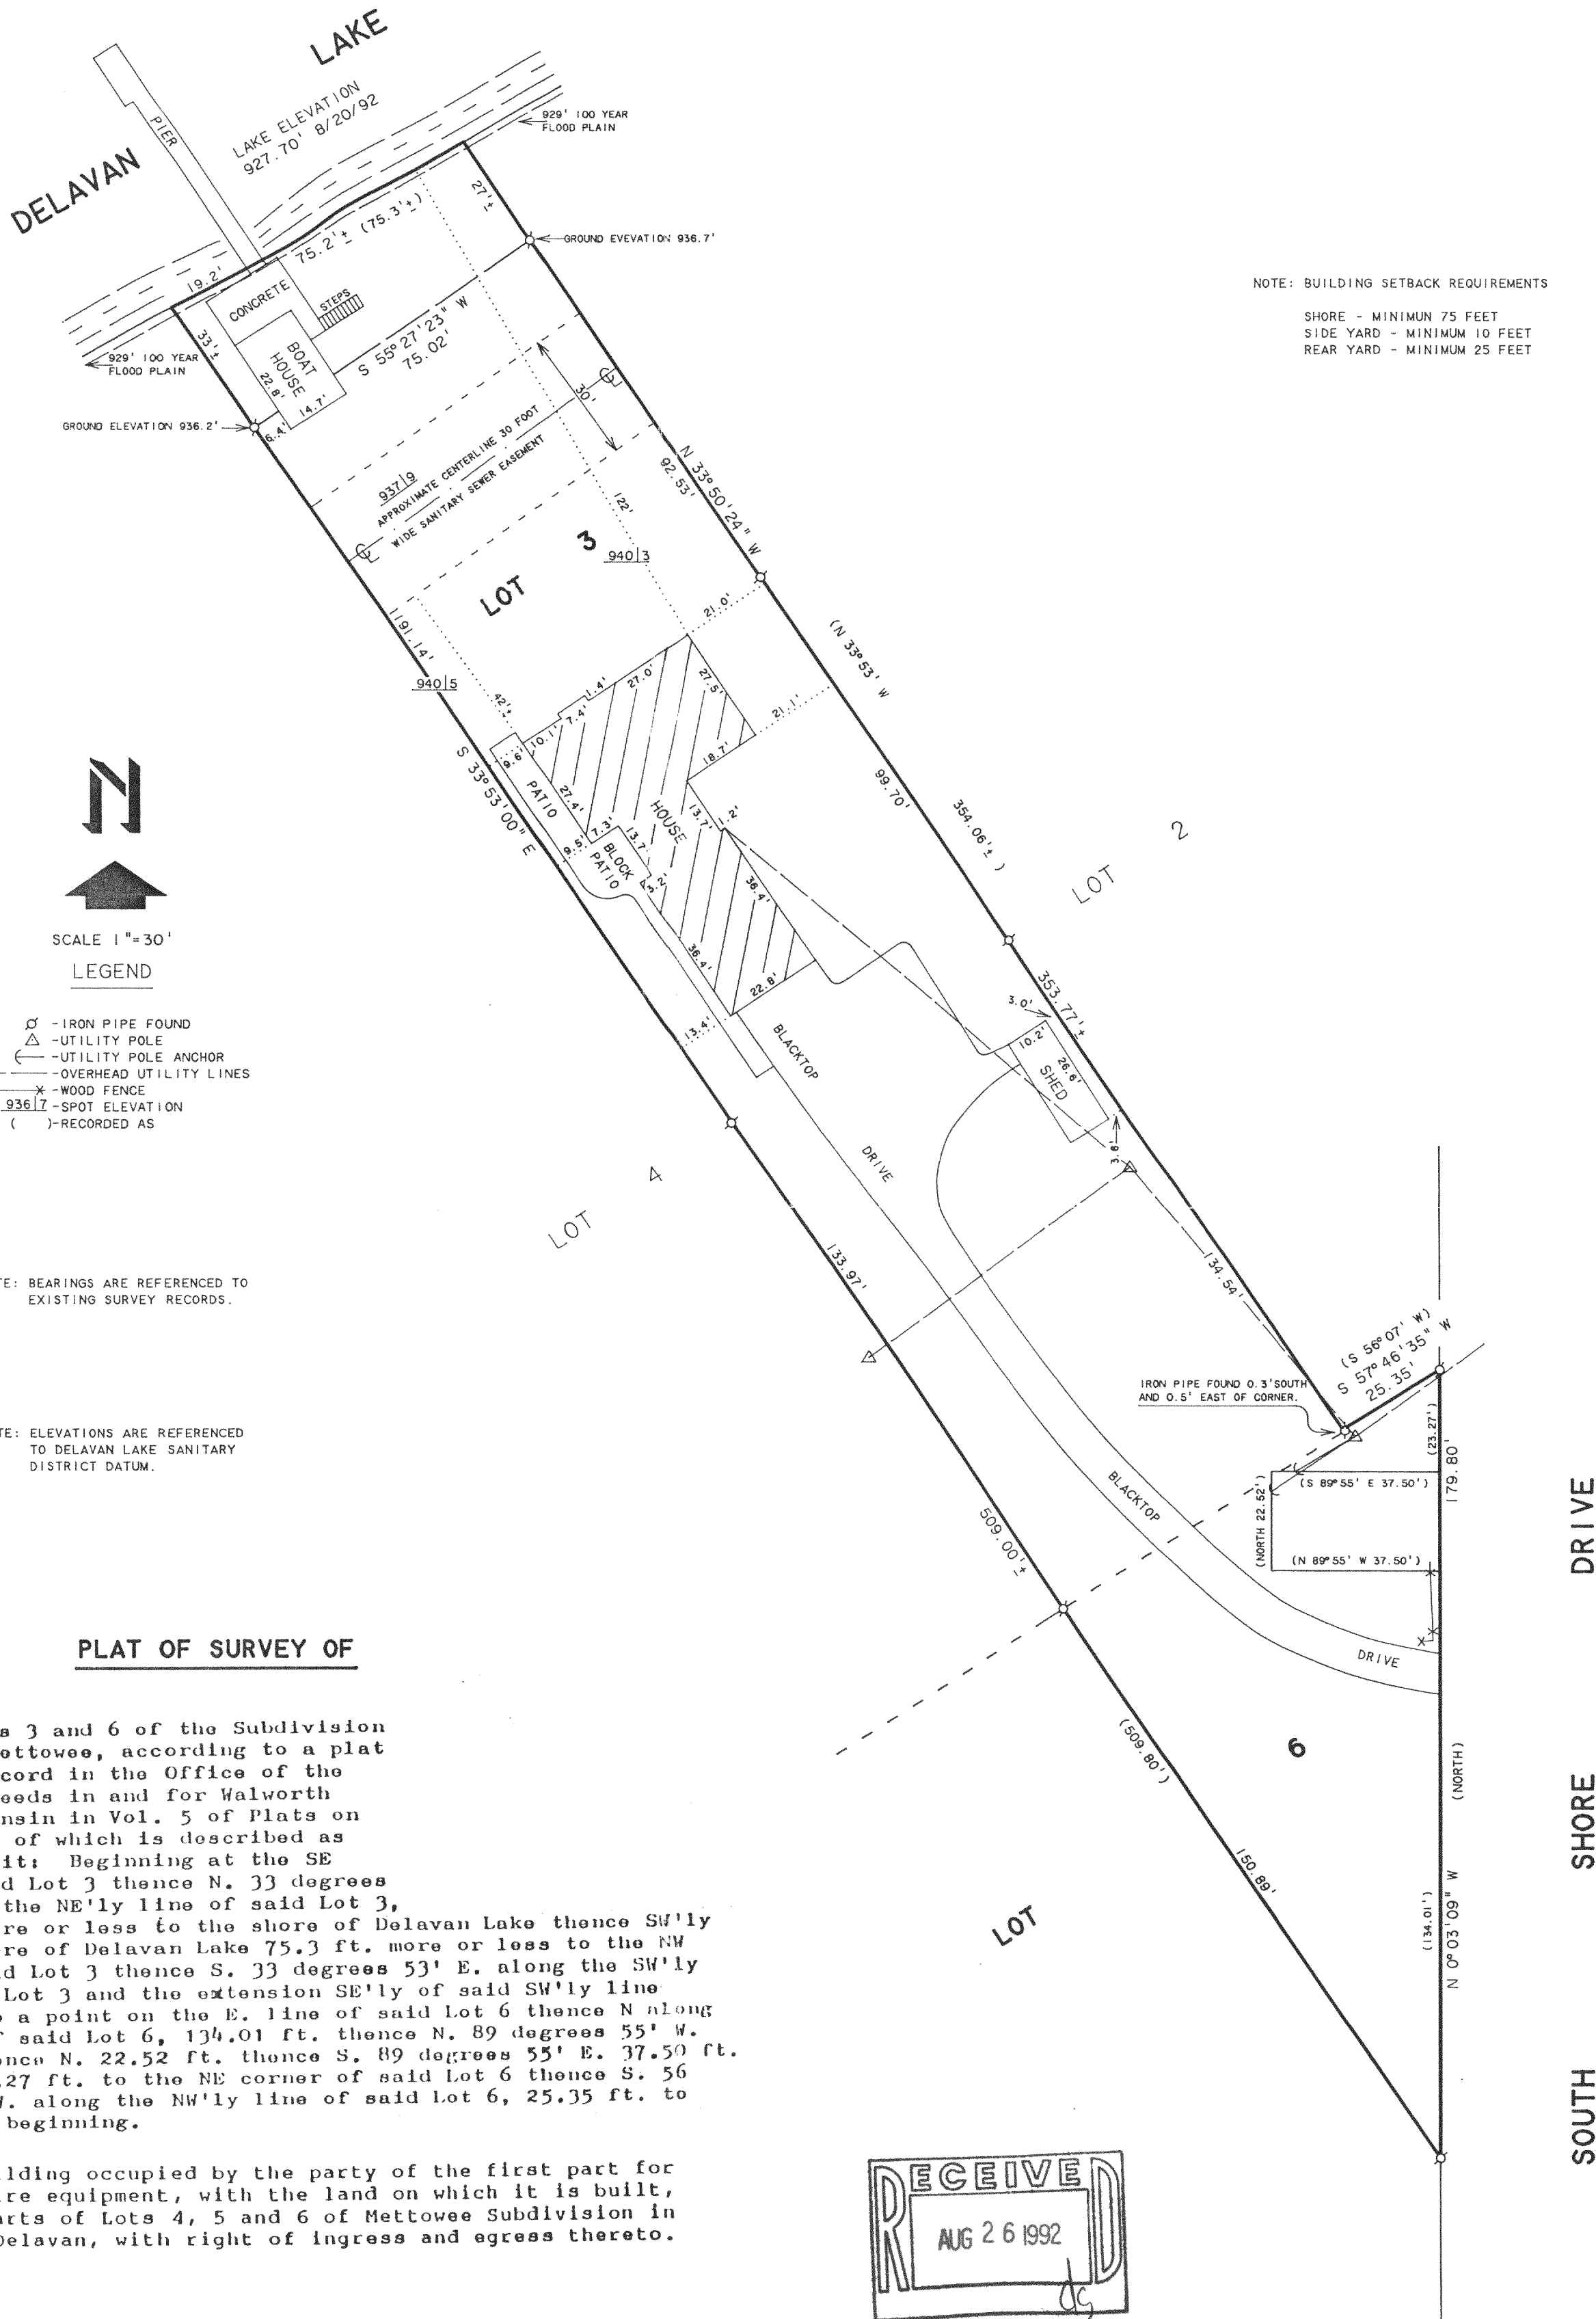

NOTE: BUILDING SETBACK REQUIREMENTS

SHORE - MINIMUM 75 FEET  
SIDE YARD - MINIMUM 10 FEET  
REAR YARD - MINIMUM 25 FEET

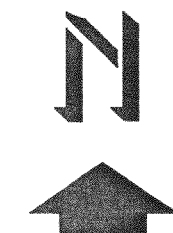

SCALE 1"=30'

LEGEND

- - IRON PIPE FOUND
- △ - UTILITY POLE
- ⊙ - UTILITY POLE ANCHOR
- - OVERHEAD UTILITY LINES
- - WOOD FENCE
- 936.17 - SPOT ELEVATION
- ( ) - RECORDED AS


NOTE: BEARINGS ARE REFERENCED TO EXISTING SURVEY RECORDS.

NOTE: ELEVATIONS ARE REFERENCED TO DELAVAN LAKE SANITARY DISTRICT DATUM.

PLAT OF SURVEY OF

A part of Lots 3 and 6 of the Subdivision of Lot 1 of Mettowee, according to a plat thereof of record in the Office of the Register of Deeds in and for Walworth County, Wisconsin in Vol. 5 of Plats on page 242, all of which is described as follows, to-wit: Beginning at the SE corner of said Lot 3 thence N. 33 degrees 53' W. along the NE'y line of said Lot 3, 354.06 ft. more or less to the shore of Delavan Lake thence SW'y along the shore of Delavan Lake 75.3 ft. more or less to the NW corner of said Lot 3 thence S. 33 degrees 53' E. along the SW'y line of said Lot 3 and the extension SE'y of said SW'y line 509.80 ft. to a point on the E. line of said Lot 6 thence N along the E line of said Lot 6, 134.01 ft. thence N. 89 degrees 55' W. 37.50 ft. thence N. 22.52 ft. thence S. 89 degrees 55' E. 37.50 ft. thence N. 23.27 ft. to the NE corner of said Lot 6 thence S. 56 degrees 07' W. along the NW'y line of said Lot 6, 25.35 ft. to the place of beginning.

The frame building occupied by the party of the first part for storage of fire equipment, with the land on which it is built, located on parts of Lots 4, 5 and 6 of Mettowee Subdivision in the Town of Delavan, with right of ingress and egress thereto.

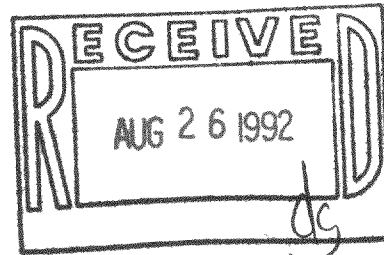

I HEREBY CERTIFY THAT I HAVE SURVEYED THE ABOVE DESCRIBED PROPERTY AND THAT THE ABOVE MAP IS A TRUE REPRESENTATION THEREOF AND SHOWS THE SIZE AND LOCATION OF THE PROPERTY, ITS EXTERIOR BOUNDARIES, THE LOCATION OF ALL VISIBLE STRUCTURES AND DIMENSIONS OF ALL PRINCIPAL BUILDINGS THEREON, BOUNDARY FENCES, APPARENT EASEMENTS, ROADWAYS AND VISIBLE ENCROACHMENTS, IF ANY, TO THE BEST OF MY KNOWLEDGE AND BELIEF.

THIS SURVEY IS MADE FOR THE USE OF THE PRESENT OWNERS OF THE PROPERTY, AND ALSO THOSE WHO PURCHASE, MORTGAGE, OR GUARANTEE THE TITLE THERETO WITHIN ONE (1) YEAR FROM DATE HEREON.

*David F. Abell*  
DAVID F. ABELL  
WISCONSIN REGISTERED LAND SURVEYOR, S-1596

ORDERED BY: THE RAULAND AGENCY  
P.O. BOX 159  
WALWORTH, WI. 53184

OWNER: JOHN JOHNSON  
2901 SOUTH SHORE DRIVE  
DELANAV, WI. 53115

August 10, 1992  
DATE  
NOTE: THIS IS NOT A CERTIFIED COPY UNLESS SEALED.

REVISED - 8/14/92  
REVISED - 8/20/92

JOB NUMBER - 92176