


GEORGE T. DUNHAM
SURVEYING & SUBDIVIDING
DELAVAN, WISCONSIN

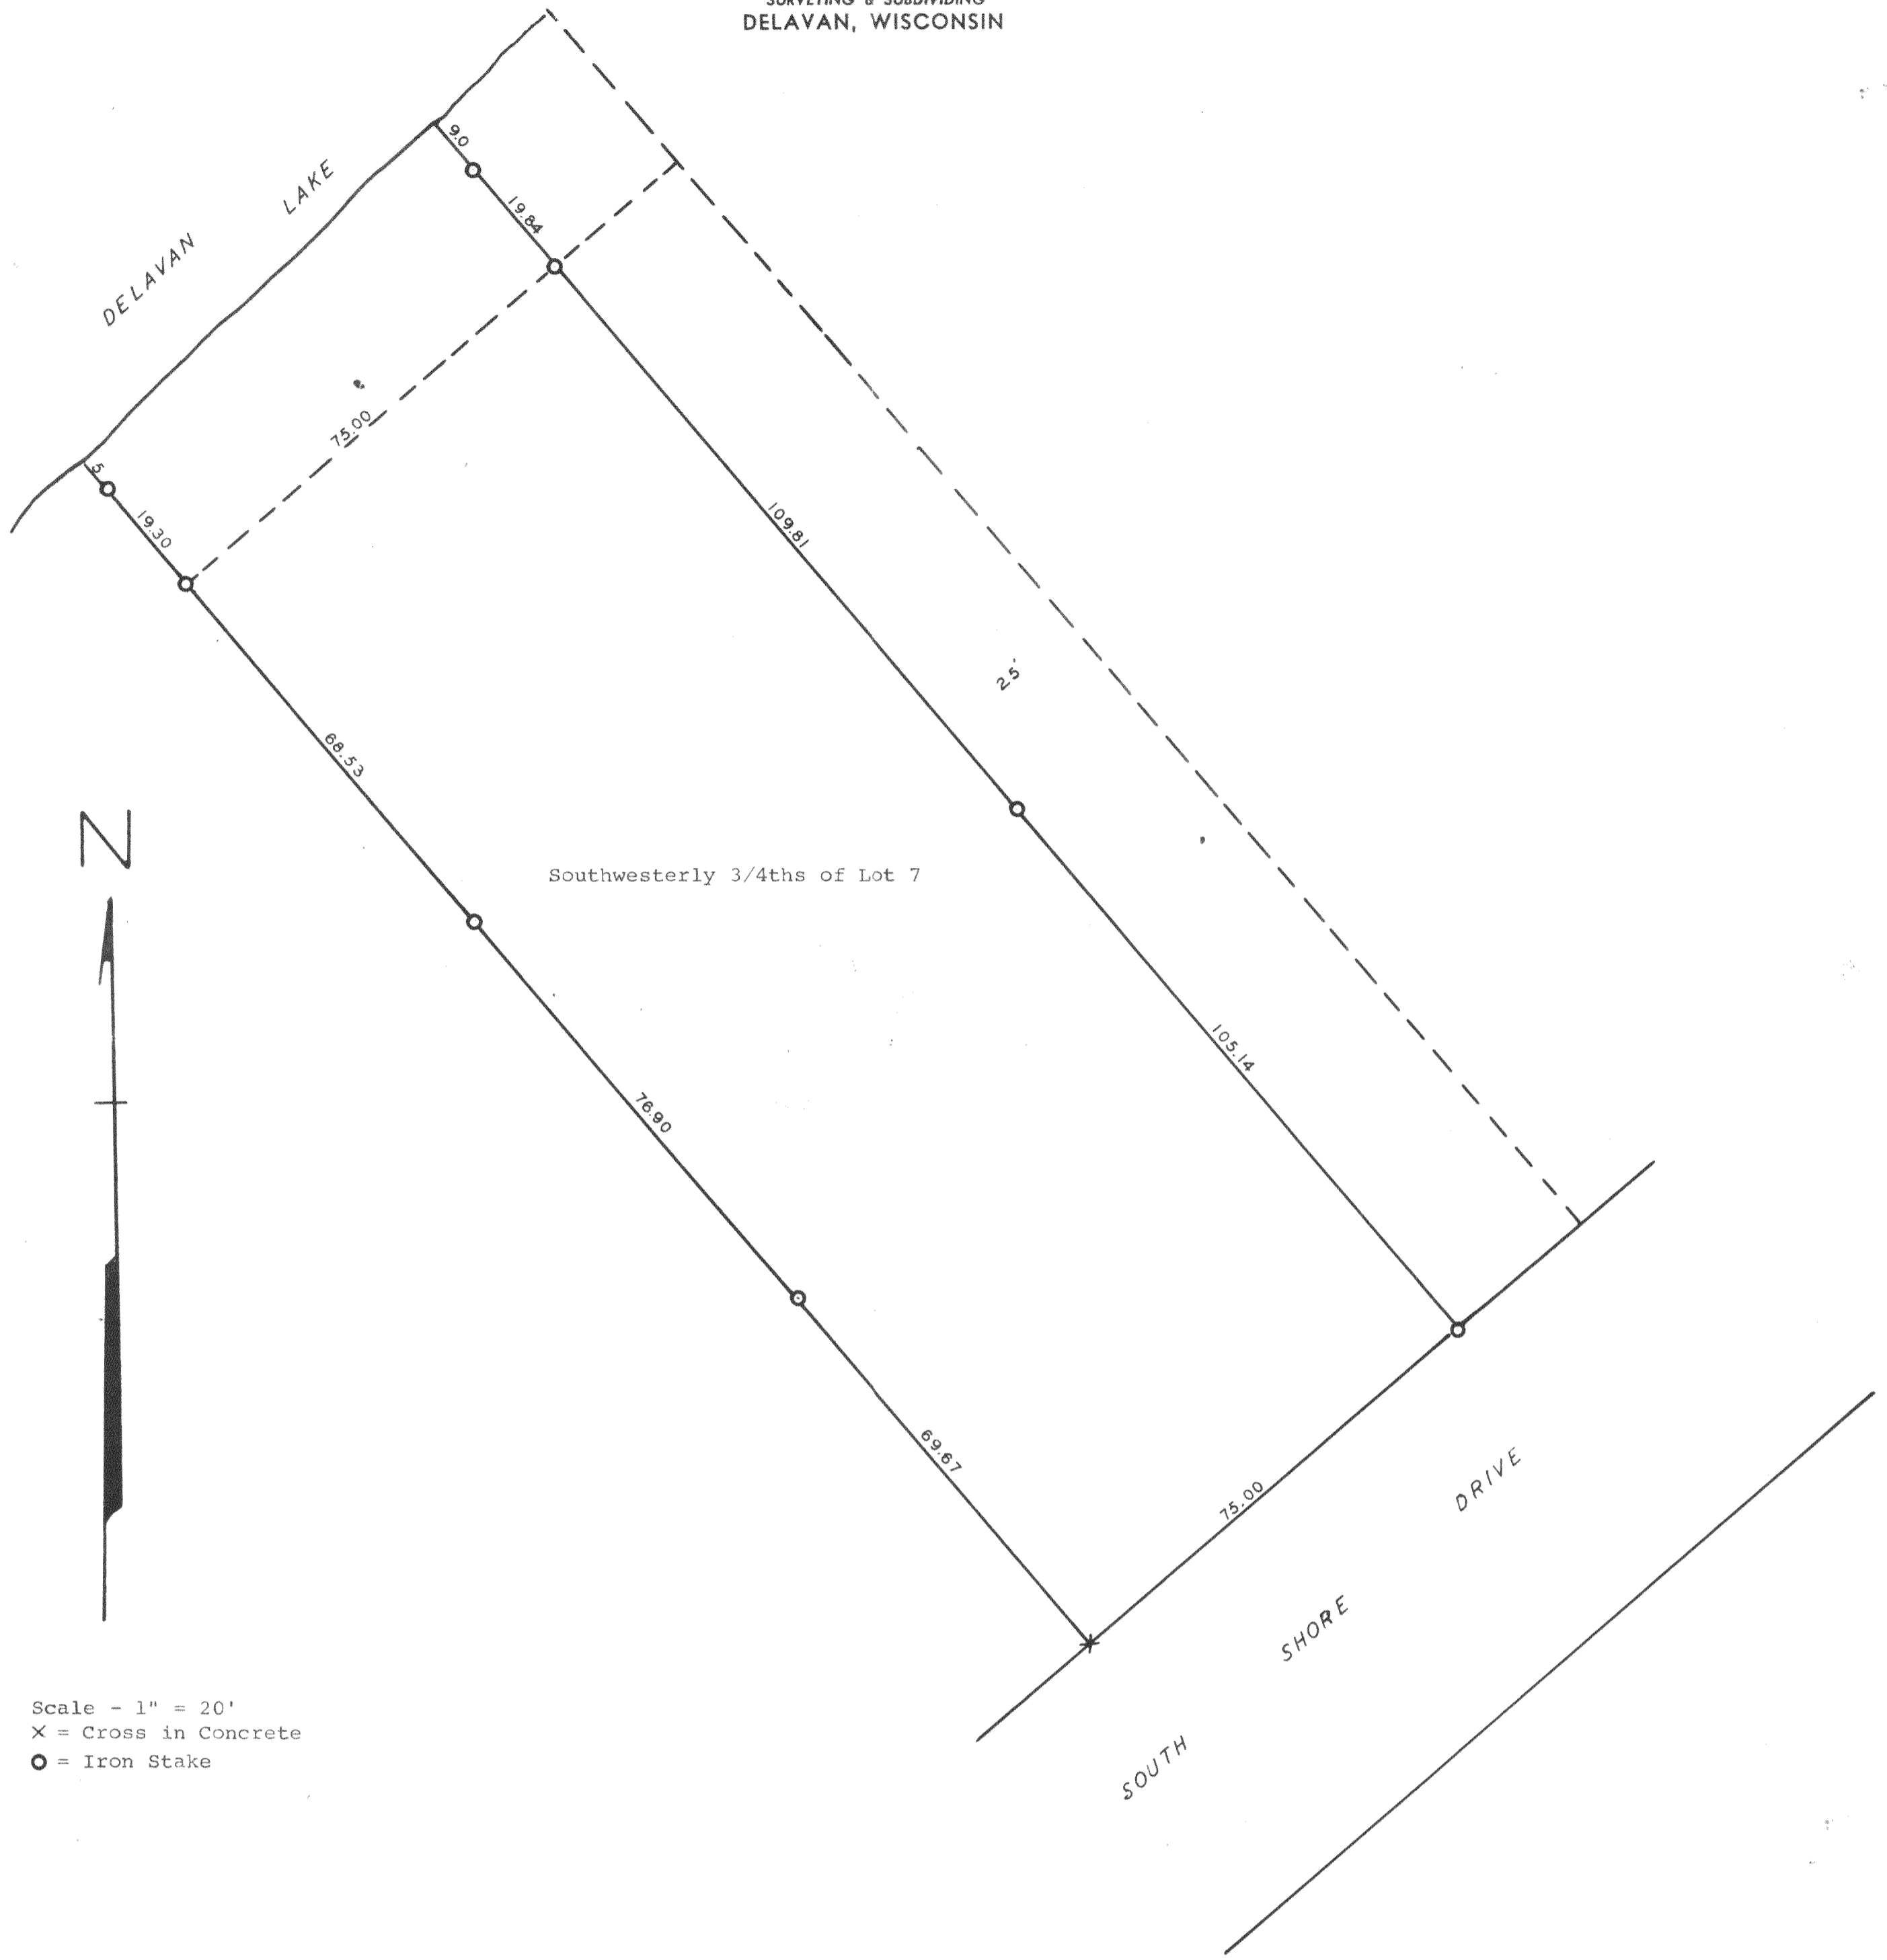

Southwesterly 3/4ths of Lot 7

Scale - 1" = 20'
X = Cross in Concrete
O = Iron Stake

Plat of survey of the Southwesterly 3/4ths of Lot 7
of The Harrington Subdivision located in Section 27
T 2 N R 16 E, Walworth County, Wisconsin.
October 14, 1964

George T. Dunham
George T. Dunham, Surveyor

FHA-11