


GEORGE T. DUNHAM  
SURVEYING & SUBDIVIDING  
DELAVAN, WISCONSIN

N



Scale - 1" = 20'  
○ = Iron Pipe

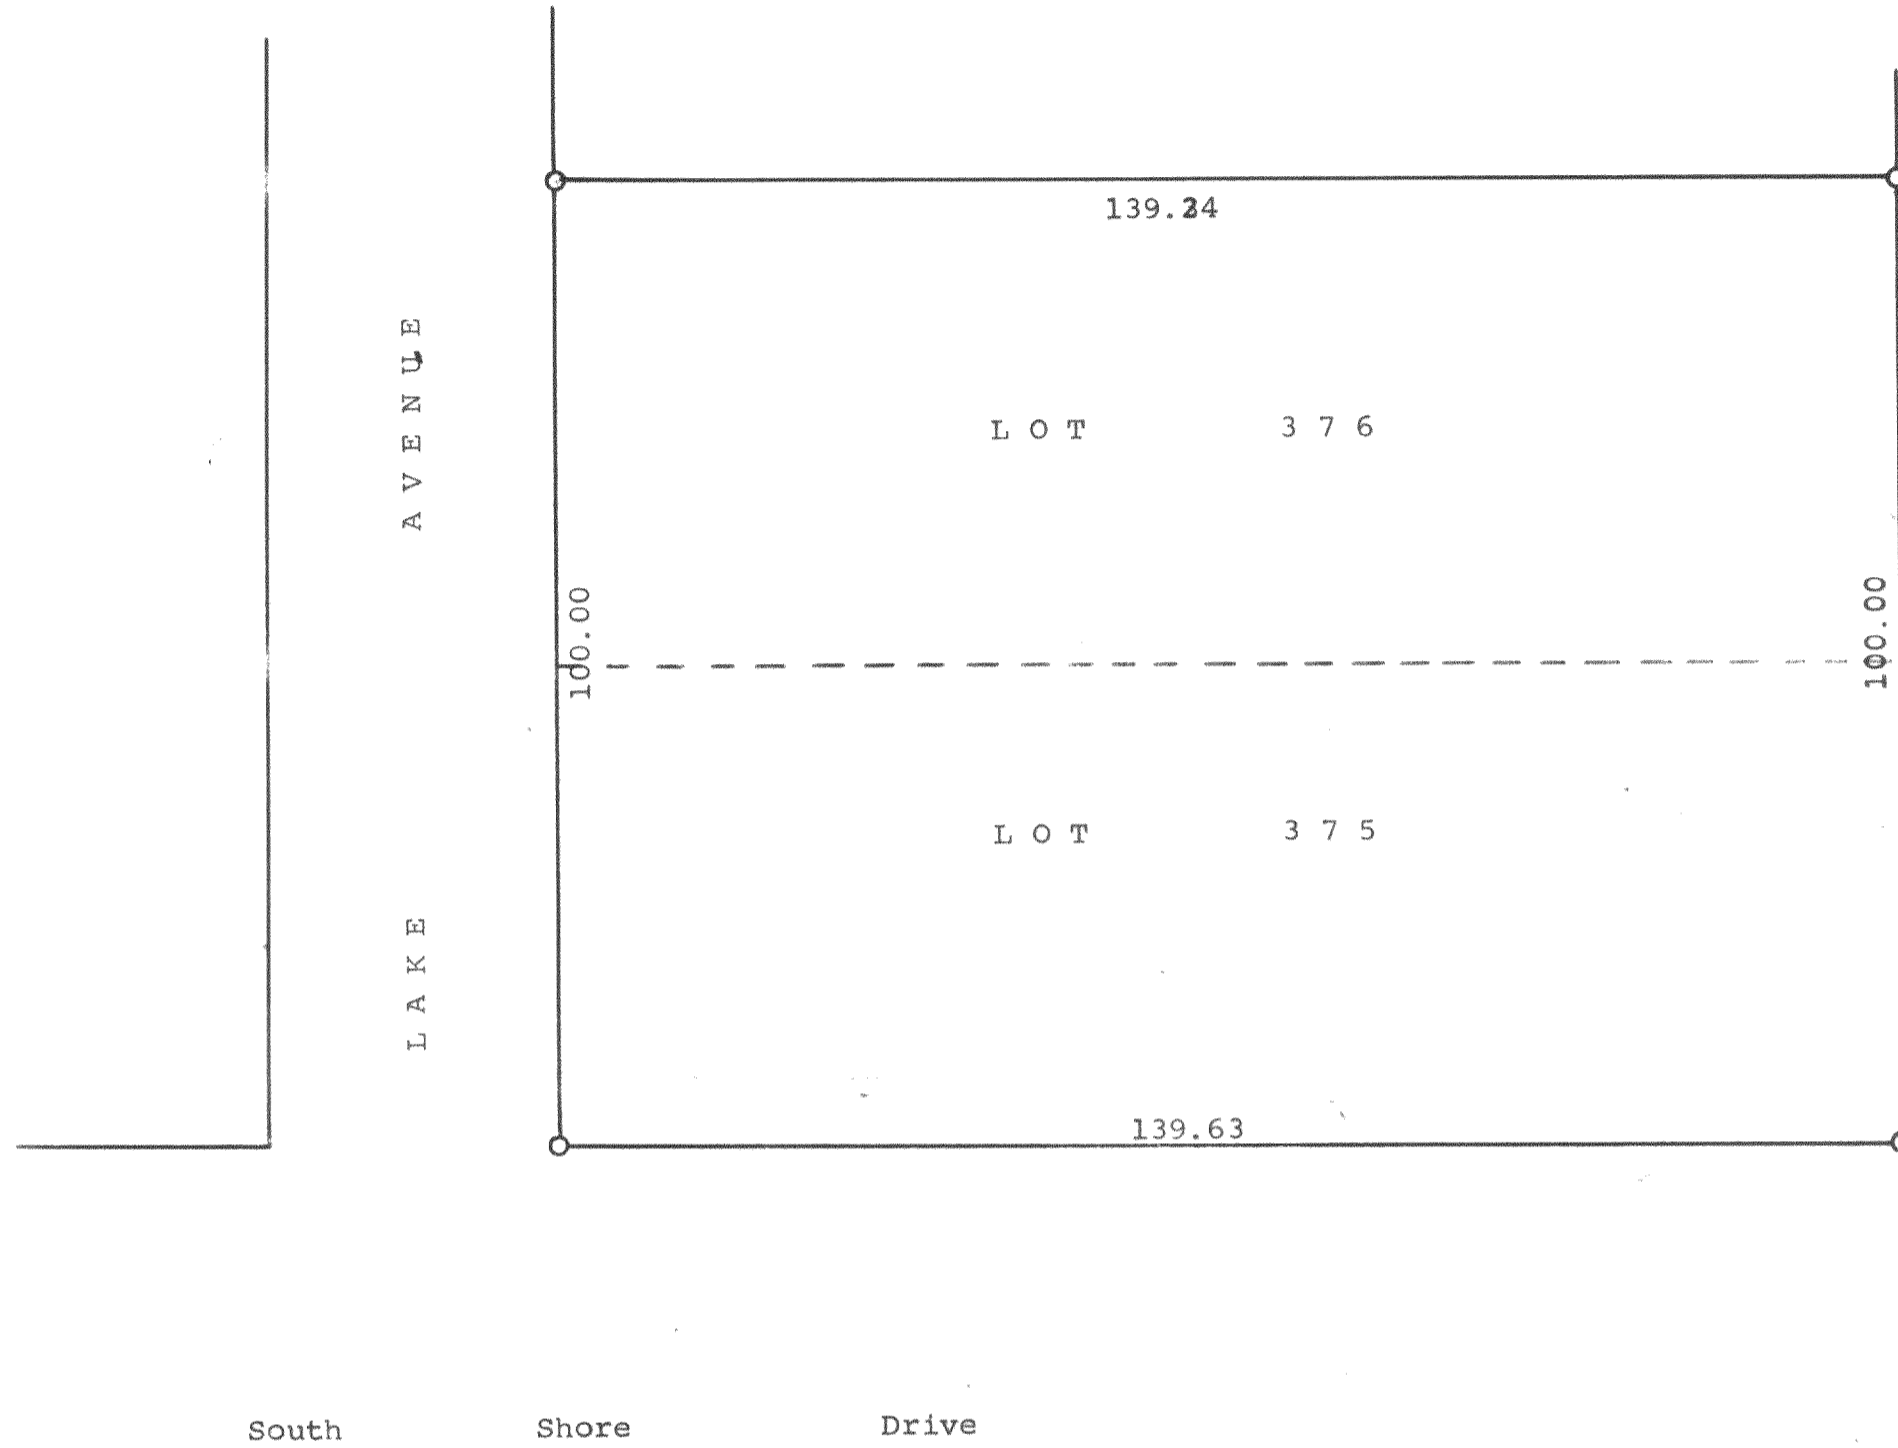

Plat of survey of Lots 375 and 376 in Lake Delavan Highlands  
located in the Town of Delavan, Walworth County, Wisconsin  
December 11, 1963

*George T. Dunham*  
George T. Dunham, Surveyor

216-175

FLAD-283  
" 284