

ABELL  
SURVEYING & MAPPING  
DELAN, WISCONSIN 53115  
414-728-6737


N



SCALE 1"=30'

LEGEND

Ø - IRON PIPE FOUND  
GRD. ELEV. - GROUND ELEVATION  
( ) - RECORDED AS

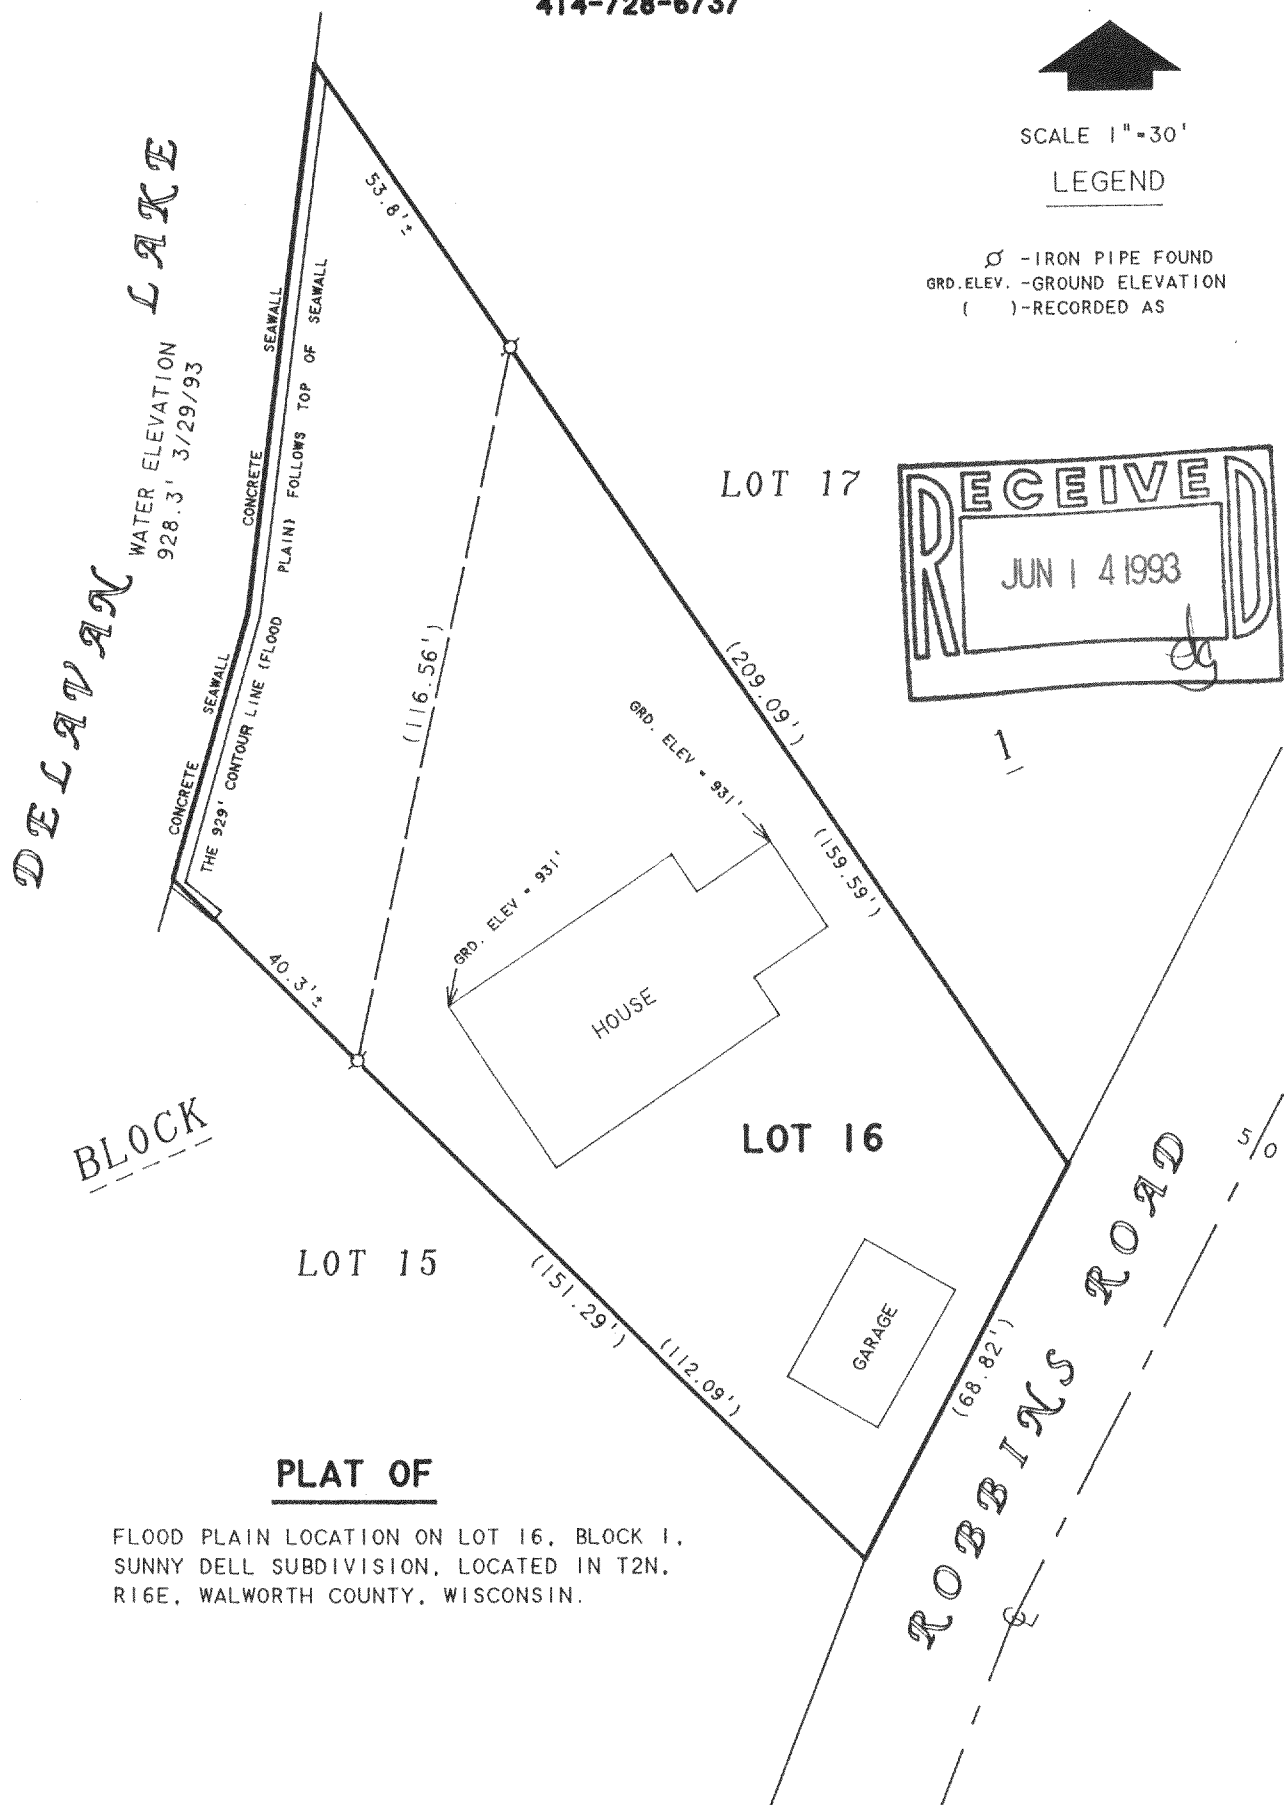

ORDERED BY: STEBNITZ BUILDERS  
P.O. BOX 526  
DELAN, WI 53115

OWNER: JOHN HIPCHEN  
4431 ROBBINS RD  
DELAN, WI 53115

David F. Abell

DAVID F. ABELL  
WISCONSIN REGISTERED LAND SURVEYOR, S-1596

March 29, 1993

DATE: March 29, 1993 JOB NUMBER - 93046  
NOTE: THIS IS NOT A CERTIFIED COPY UNLESS SEALED.

FSU-16

216-1773