

DUNHAM SURVEYING, S.C.
SURVEYING & SUBDIVIDING
DELAVER, WISCONSIN 53115

WILLOW POINT DRIVE

EAST 66.00

LOT 3

0.3' West
of fence

North end of
Woven Wire Fence

North end of cyclone
fence line

1.7' West
of fence

1.1' E. of
fence

Scale - 1" = 30'
o = 1" Iron Pipe Found
x = 3/4" Iron Pipe Found
x = 3/4" Iron Pipe Found 2' below
surface. Set 1 1/4" X 24" Iron
pipe at ground level.

--- = Fence Line
(0.00) = Recorded distance
Bearings referenced to the assumed bearing
of East along the south line Willow Point
Drive

Survey ordered by: Century 21, Skandia
Realty
312 South 7th Street
Delaver, WI

• = 3/4" Iron Pipe Set

0.15' W.
of fence

1.1' E. of 2.8'
fence

1.6' 29.9' 12.6' well

12.9' 8.4' 54.2'

30.0' 33.6'

House

43.1'

12.3'

1.0'

147.68'

2.9'

87.45'

0.4'

63' ±

DELAVER

LAKE

N89°41'18"W

62.94 (63)

STATE OF WISCONSIN)SS
COUNTY OF WALWORTH)



I, George T. Dunham, Surveyor, certify that I have surveyed
the property described as follows:

Lot 3 in The Hamlet of Bon Secour, a subdivision located in
Section 29, T 2 N, R 16 E, Walworth County, Wisconsin,
and that the plat shown hereon is a correct representation thereof and
shows the size and location of the property, its exterior boundaries, the
location of all visible structures and dimensions of all principal
buildings thereon, boundary fences, apparent easements, roadways and
visible encroachments, if any, and that I have surveyed the property
hereon described, according to the official records, to the best of my
knowledge and belief.

July 29, 1989

Updated and recertified to this
3rd day of May, 1993

George T. Dunham
George T. Dunham, Surveyor

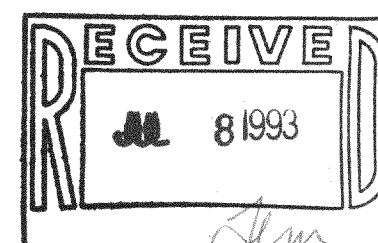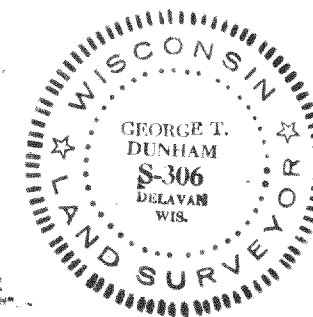

FBO-3

216-1154
216-1801