



DUNHAM SURVEYING, S.C.
SURVEYING & SUBDIVIDING
DELAVER, WISCONSIN 53115



Scale - 1" = 20'
 • = Concrete Monument
 ✕ = Mark in subsoil found. Set 3/4" I.P.
 ⚬ = 3/4" I.P. Found
 ⚬ = Posey Pin Found
 3/4" I.P. Set
 Bearings referenced to the south line of Adelia Ave. with the recorded bearing of S89°43'E
 Survey ordered by:
 Century 21, Skandia Realty
 312 South 7th Street
 Delavan, WI 53115
 ⚬ = 3/4" X 24" Iron Pipe Set

STATE OF WISCONSIN) SS
 COUNTY OF WALWORTH)
 I, George T. Dunham, Surveyor, certify that I have surveyed the property described as follows:
 Lot 25 of Hoag's Addition and Lots 1-4 inclusive in Block 14 of South Shore Manor First Addition, located in Section 32, T 2 N, R 16 E, Walworth County, Wisconsin
 and that the plat shown hereon is a correct representation thereof and shows the size and location of the property, its exterior boundaries, the location of all visible structures and dimensions of all principal buildings thereon, boundary fences, apparent easements, roadways and visible encroachments, if any, and that I have surveyed the property hereon described, according to the official records, to the best of my knowledge and belief.
 June 30, 1993

George T. Dunham
 George T. Dunham, Surveyor

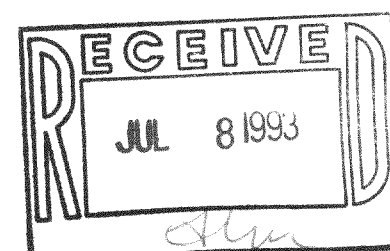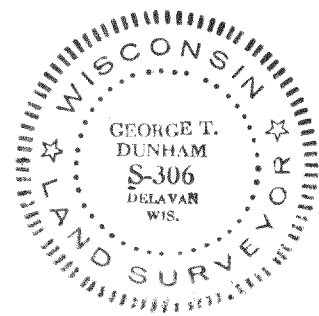

216-1807

FSS1-57
 FSS1-58
 FSS1-59
 FHO-16