



ABELL
SURVEYING & MAPPING
DELAVAN, WISCONSIN 53115
414-728-6737

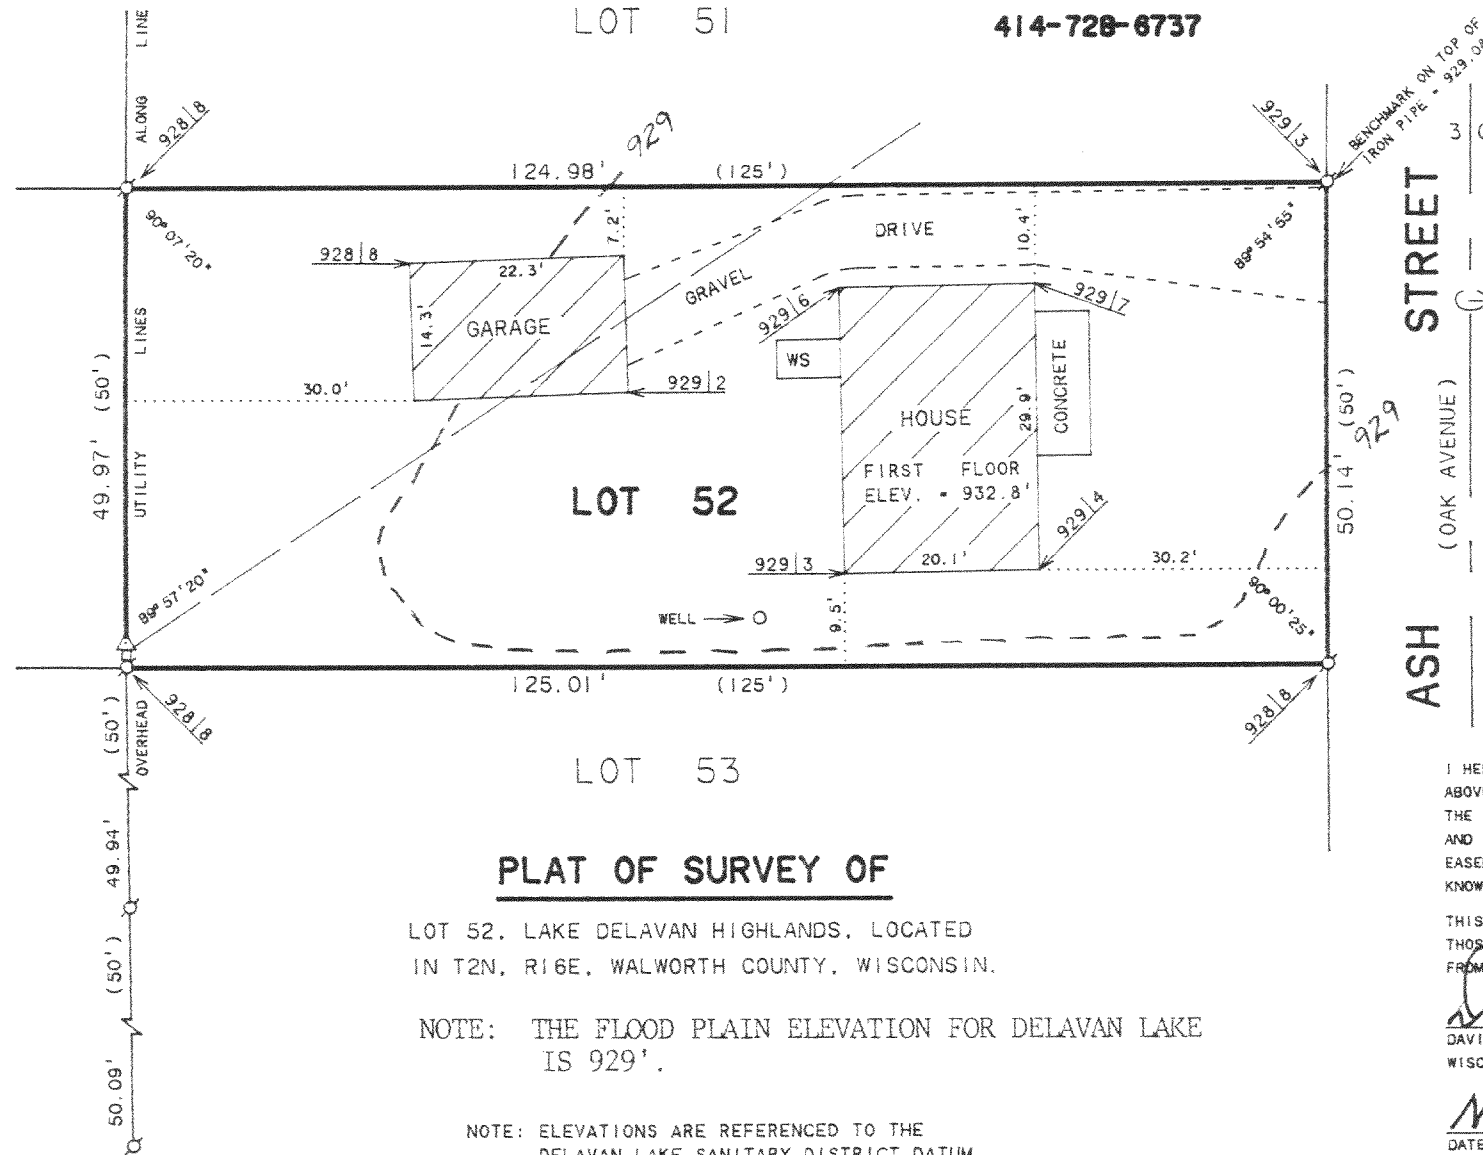

SCALE 1" = 20'
LEGEND

- - IRON PIPE FOUND
- - UTILITY PED.
- △ - UTILITY POLE
- WS - WOOD STOOP
- - OVERHEAD UTILITY LINES
- ← 929/7 - GROUND ELEVATION
- () - RECORDED AS

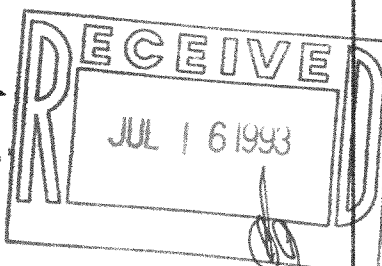

ORDERED BY: STOLL HOME IMPROVMENTS
REVISED: 6/7/93 TO SHOW 929 CONTOUR LINE.

PLAT OF SURVEY OF

LOT 52, LAKE DELAVAN HIGHLANDS, LOCATED
IN T2N, R16E, WALWORTH COUNTY, WISCONSIN.

NOTE: THE FLOOD PLAIN ELEVATION FOR DELAVAN LAKE
IS 929'.

NOTE: ELEVATIONS ARE REFERENCED TO THE
DELAVAN LAKE SANITARY DISTRICT DATUM.

I HEREBY CERTIFY THAT I HAVE SURVEYED THE ABOVE DESCRIBED PROPERTY AND THAT THE ABOVE MAP IS A TRUE REPRESENTATION THEREOF AND SHOWS THE SIZE AND LOCATION OF THE PROPERTY, ITS EXTERIOR BOUNDARIES, THE LOCATION OF ALL VISIBLE STRUCTURES AND DIMENSIONS OF ALL PRINCIPAL BUILDINGS THEREON, BOUNDARY FENCES, APPARENT EASEMENTS, ROADWAYS AND VISIBLE ENCROACHMENTS, IF ANY, TO THE BEST OF MY KNOWLEDGE AND BELIEF.

THIS SURVEY IS MADE FOR THE USE OF THE PRESENT OWNERS OF THE PROPERTY, AND ALSO THOSE WHO PURCHASE, MORTGAGE, OR GUARANTEE THE TITLE THERETO WITHIN ONE (1) YEAR FROM DATE HEREOF.

David F. Abell
DAVID F. ABELL
WISCONSIN REGISTERED LAND SURVEYOR, S-1596

November 13, 1991 REVISED DATE MAY 13, 1993
DATE JOB NUMBER - 91250
NOTE: THIS IS NOT A CERTIFIED COPY UNLESS SEALED.

FLAD-45

216-1826