


GEORGE T. DUNHAM
SURVEYING & SUBDIVIDING
DELAVAN, WISCONSIN

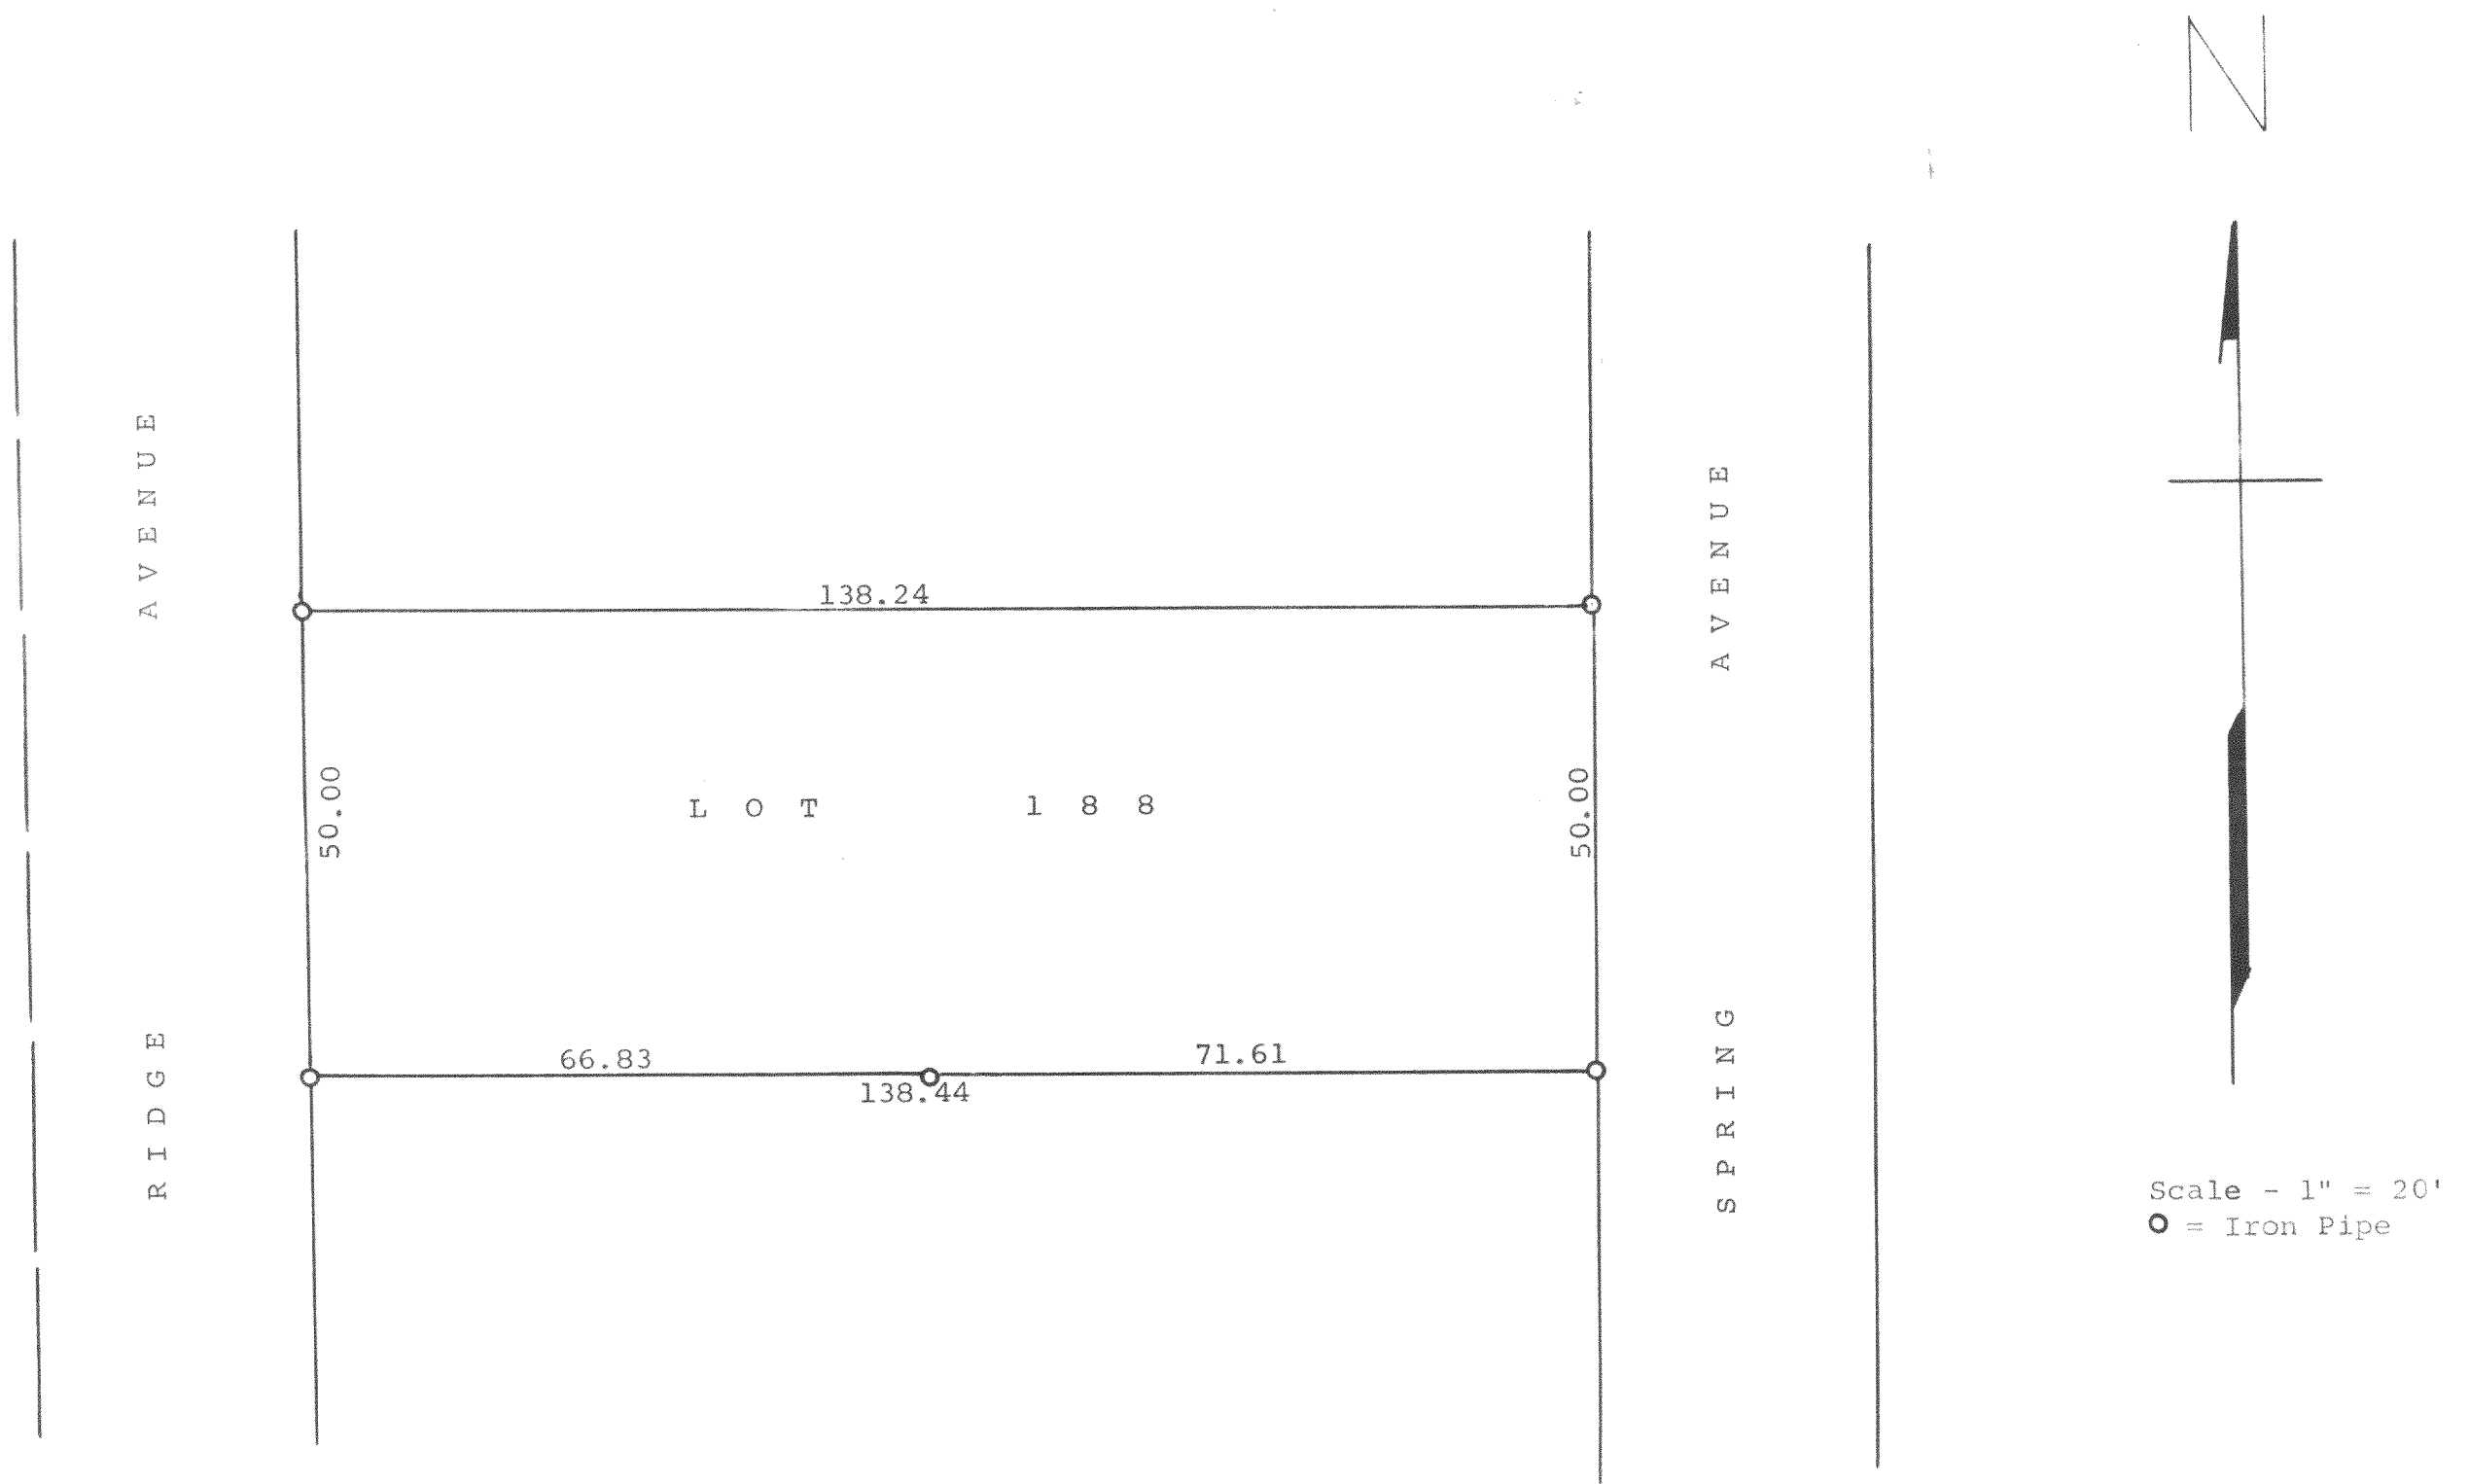

Plat of survey of Lot 188, Lake Delavan Highlands, Town of
Delavan, Walworth County, Wisconsin.
September 4, 1963

George T. Dunham
George T. Dunham, Surveyor

216-185

FLAD-146