
PLAT OF SURVEY

LOT 8 and the West 1/2 of LOT 9, BLOCK 1, INLET OAKS SUBDIVISION No. 4, located in Section 15, Township 2 North, Range 16 East in the Town of Delavan, Walworth County, Wisconsin.

Survey For: American Dream Builders

Proposed house was staked on actual corners with 5 foot control on the North house line. The Contractor will be responsible to field verify all stakes for location and dimension prior to construction. If any discrepancies should arise, notify this office at once.


Proposed Address: _____ Delavan Drive Proposed Fn. Fl.:

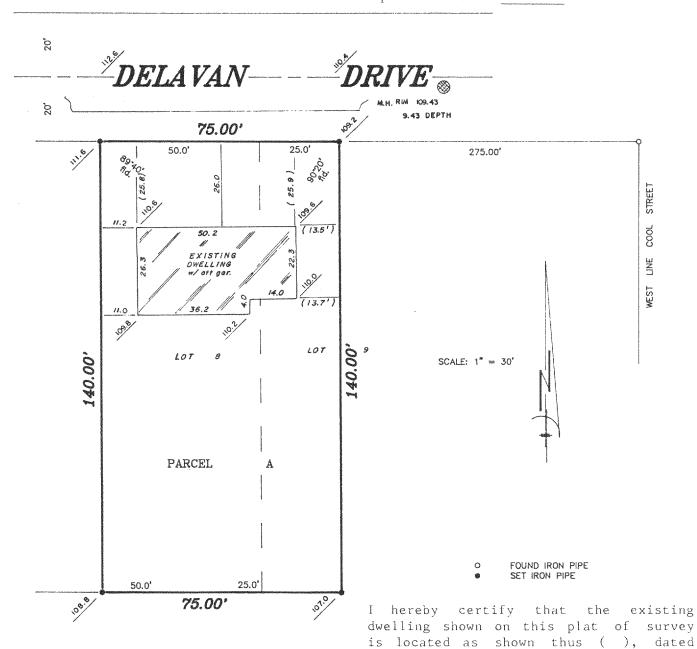



B.W. SURVEYING

Land Surveys
Mapping And Planning
35117 Academy Road
Burlington, Wisconsin 53105
(414) 534-4109

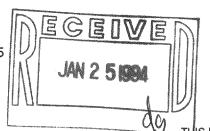

ROBERT J. WETZEL S-1778
BURLINGTON. WI

this 12th day of November, 1993.

THIS IS NOT AN ORIGINAL PRINT UNLESS THIS SEAL IS RED

"I hereby certify that I have surveyed the above described property and that the above map is a true representation thereof and shows the size and location of the property, its exterior boundaries, the location of all visible structures and dimensions of all principal buildings thereon, boundary fences, apparent easements, roadways and encroachments, if any.

"This survey is made for the use of the present owners of the property, and those who purchase, mortgage, or guarantee the title thereto within one year from date hereof"

ROBERT J. WETZEL
REGISTERED LAND SURVERYOR - 1778

REVISED : 12/28/92

2/6/92 DATE 7,84, A JOB NUMBER

216-1917