


KOLB LAND CONSULTING, INC.
 LAND SURVEYING • SUBDIVIDING • LAND PLANNING

929 WILLIAMS STREET LAKE GENEVA, WISCONSIN 53147 414-248-3697

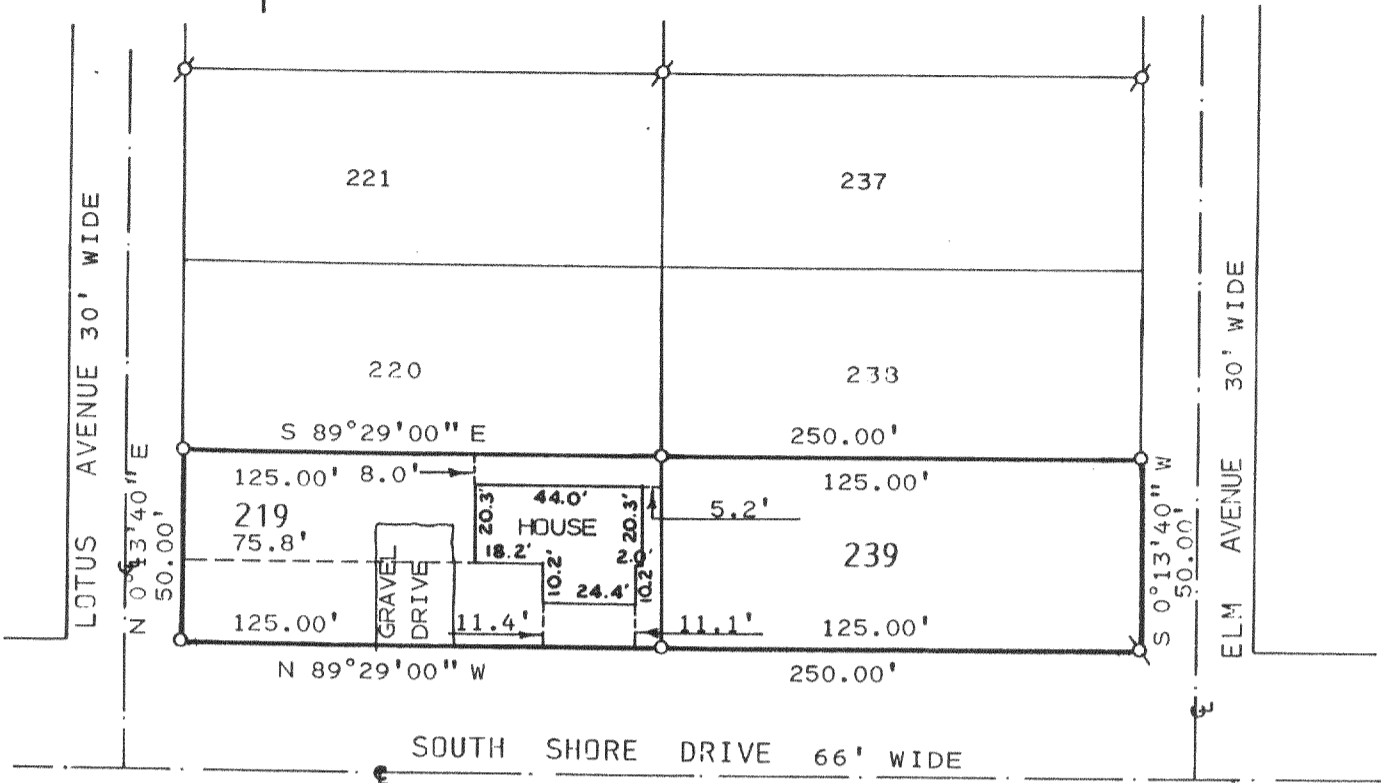

ORDERED BY: LLYOD JOHNSEN %
 BEST BUILT GARAGES
 1501 W. COURT ST.
 JANESVILLE, WI. 53547

PLAT OF SURVEY OF

LOTS 219 AND 239 OF LAKE DELAVAN
 HIGHLANDS A SUBDIVISION LOCATED IN
 SECTION 31, T2N, R16E, TOWN OF
 DELAVAN, WALWORTH COUNTY, WISCONSIN.

LEGEND


- ⊕ - IRON PIPE FOUND
- - IRON PIPE SET

NOTE: BEARING ON THE SOUTH LINE OF THE SOUTHEAST 1/4
 OF SEC. 31-2-16 IS ASSUMED S89°29'E, AS
 SHOWN ON THE RECORDED PLAR OF LAKE DELAVAN
 HIGHLANDS.



SCALE: 1" = 50'

I, HAROLD H. KOLB, DO HEREBY CERTIFY
 THAT I HAVE SURVEYED THE PROPERTY
 HEREON DESCRIBED ACCORDING TO THE
 OFFICIAL RECORDS AND THAT THE PLAT
 HEREON IS A CORRECT REPRESENTATION
 OF THE LOT LINES TO THE BEST OF MY
 KNOWLEDGE AND BELIEF.
 SURVEY NOT VALID UNLESS SURVEYOR'S SIGNATURE
 IS IN RED.

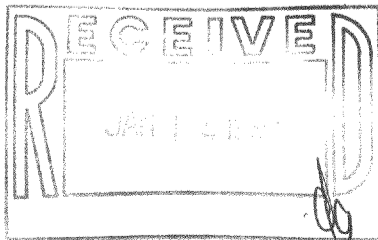

HAROLD H. KOLB
 WISCONSIN REGISTERED LAND SURVEYOR, S-187
 DATE OCTOBER 3, 1993
 REVISED _____
 REVISED _____