
ABELL SURVEYING & MAPPING

DELAVAN, WISCONSIN 53115 414-728-6737

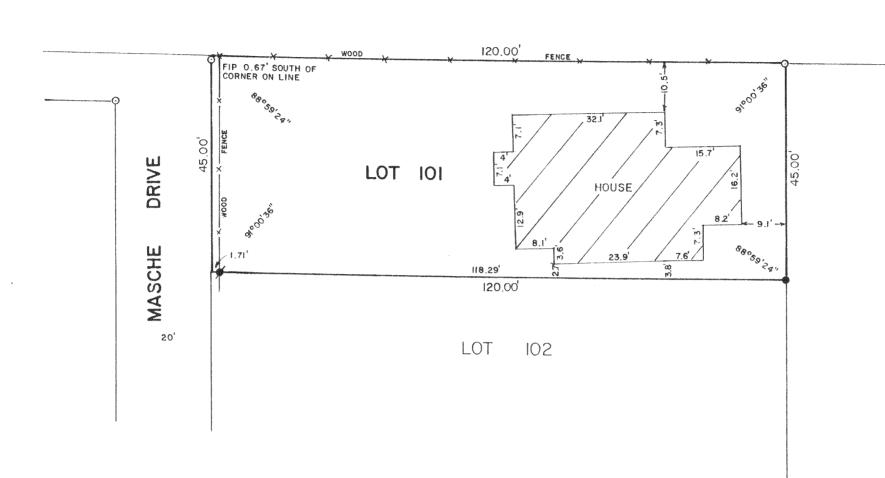

PLAT OF SURVEY OF

LOT 101, KRUMHAAR'S 2nd ADDITION TO RAVENSWOOD, T2N,R16E, WALWORTH COUNTY, WISCONSIN.

ORDERED BY: STEBNITZ BUILDERS 1102 ANN STREET DELAVAN, WI 53115





SCALE

1"=20"

LEGEND

- - IRON PIPE FOUND - IRON ROD FOUND - IRON ROD SET

I. DAVID F. ABELL. DO HEREBY CERTIFY THAT I HAVE SURVEYED THE PROPERTY HEREON DESCRIBED ACCORDING TO THE OFFICAL RECORDS AND THAT THE PLAT HEREON IS A CORRECT REPRESENTATION OF THE PROPERTY LINES TO THE BEST OF MY KNOWLEDGE AND

DAVID F. ABELL WISCONSIN REGISTERED LAND SURVEYOR. S-1596

June 1, 1994

DATE JOB NUMBER - 94056 NOTE: THIS IS NOT A CERTIFIED COPY UNLASS SEALED.