


ABELL
SURVEYING & MAPPING
 DELAVAN, WISCONSIN 53115
 414-728-6737

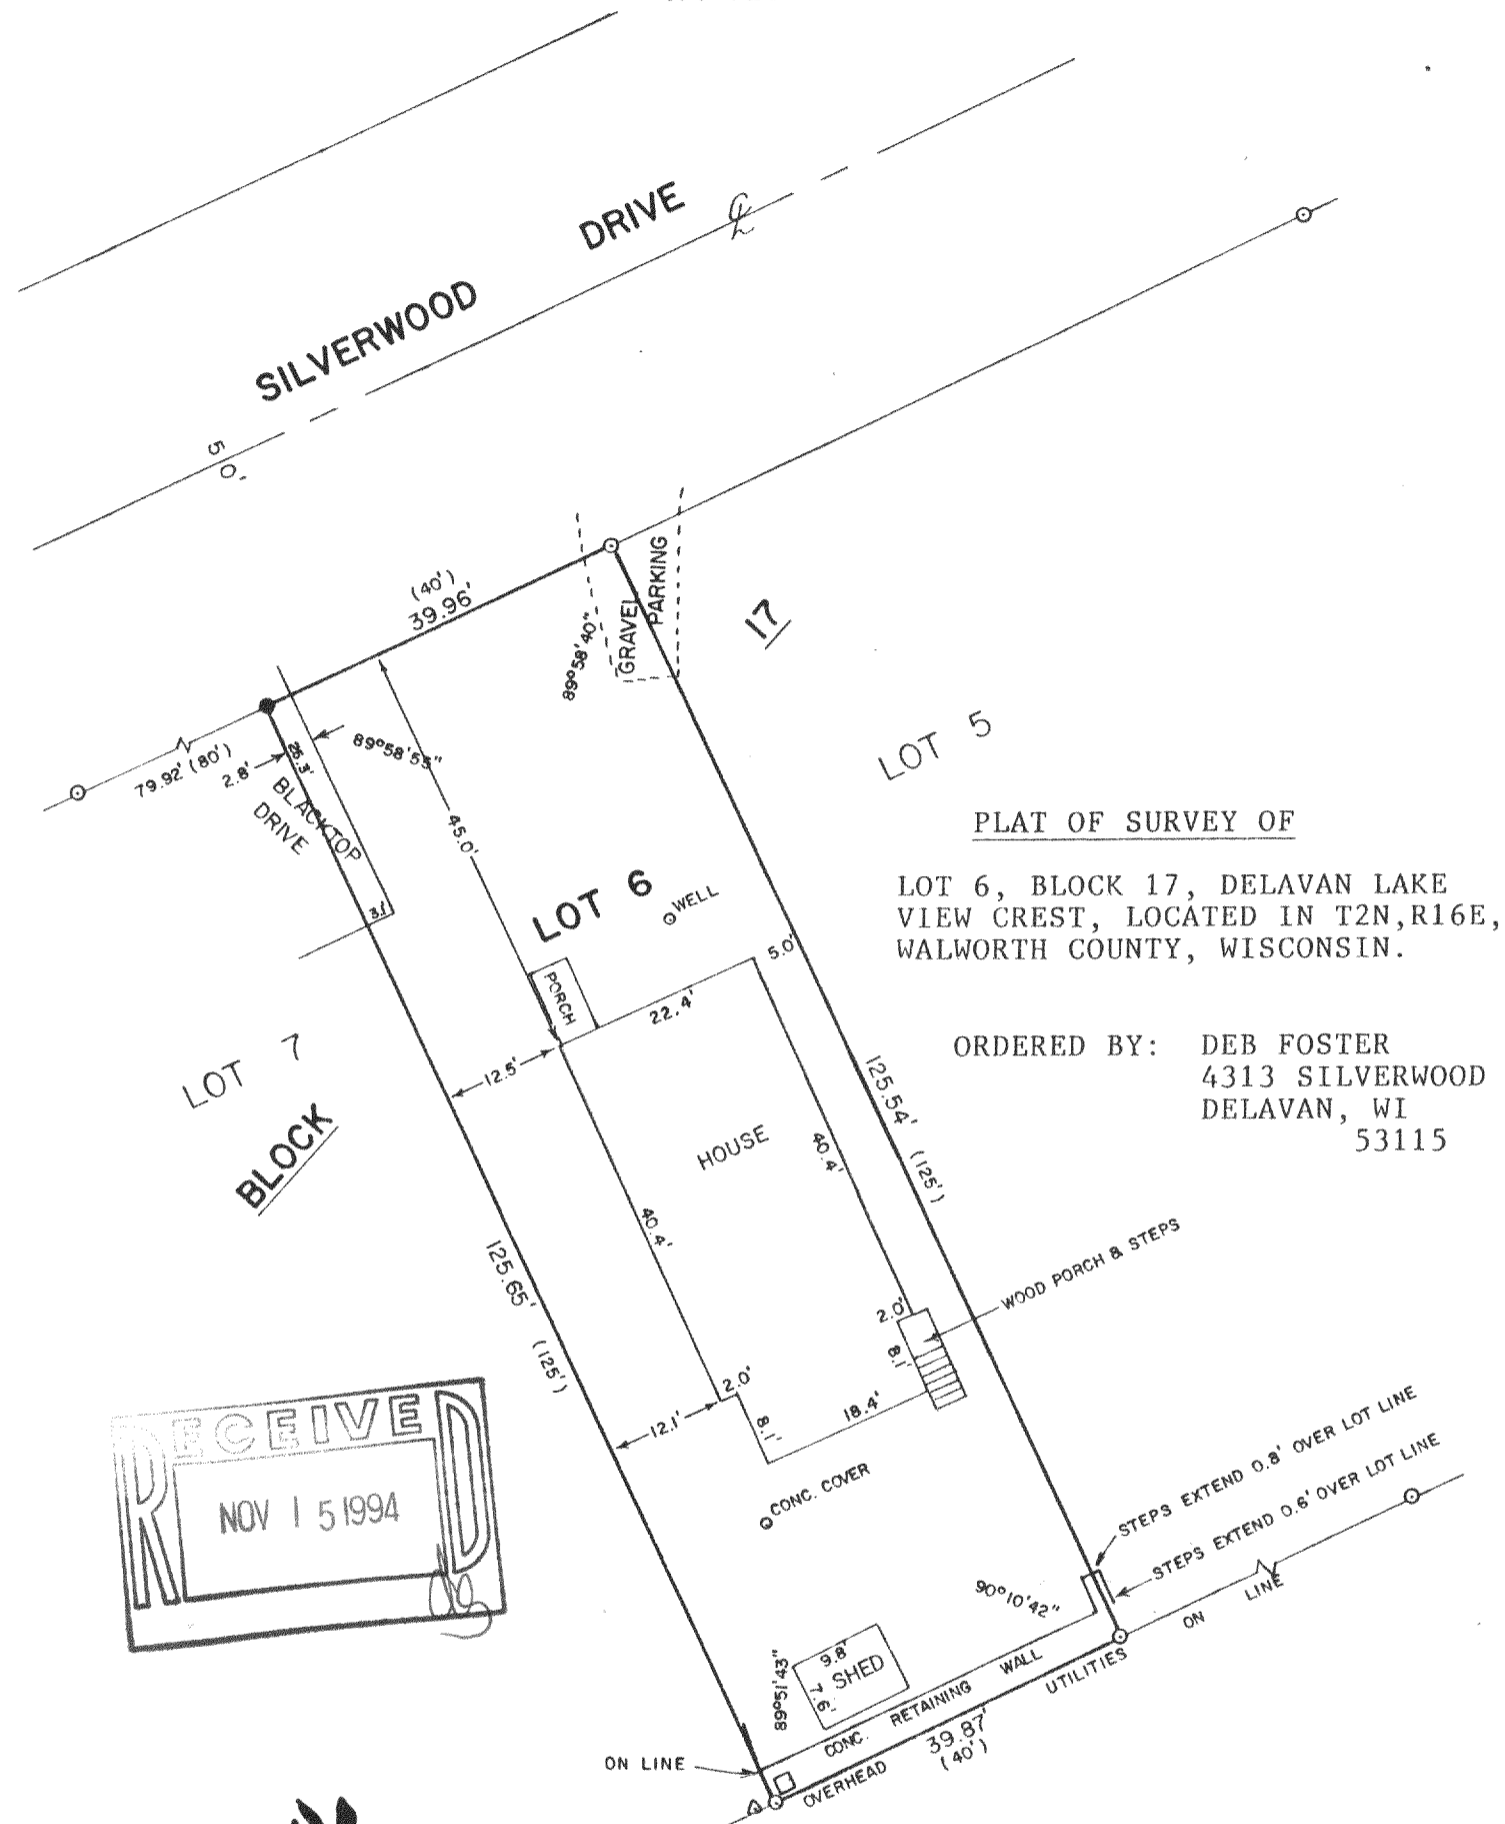

PLAT OF SURVEY OF

LOT 6, BLOCK 17, DELAVAN LAKE
 VIEW CREST, LOCATED IN T2N, R16E,
 WALWORTH COUNTY, WISCONSIN.

ORDERED BY: DEB FOSTER
 4313 SILVERWOOD
 DELAVAN, WI
 53115

SCALE - 1"=20'

LEGEND

- - IRON PIPE FOUND
- - IRON ROD SET
- () - RECORDED AS
- △ - UTILITY POLE
- - CONCRETE PIT FOR WATER VALVE

I, DAVID F. ABELL, DO HEREBY CERTIFY
 THAT I HAVE SURVEYED THE PROPERTY
 HEREON DESCRIBED ACCORDING TO THE
 OFFICIAL RECORDS AND THAT THE PLAT
 HEREON IS A CORRECT REPRESENTATION
 OF THE PROPERTY LINES TO THE BEST OF
 MY KNOWLEDGE AND BELIEF.

David F. Abell

DAVID F. ABELL
 WISCONSIN REGISTERED LAND SURVEYOR, S-1596

August 17, 1994

DATE JOB NUMBER - 94140

NOTE: THIS IS NOT A CERTIFIED COPY UNLESS SEALED.

EDLV-123

216-1989