

ABELL SURVEYING & MAPPING DELAVAN, WISCONSIN 53115 414-728-6737

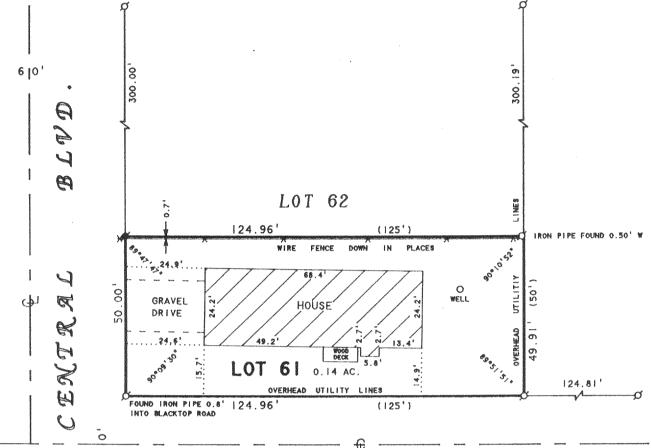

NORTH CHANNEL DRIVE

ORDERED BY: PROFESSIONAL REALTY 706 E. GENEVA ST. DELAVAN, WI. 53115

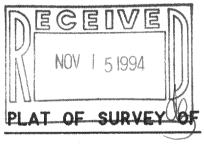

LOT 61 OF LAKE DELAVAN HIGHLANDS, LOCATED IN T2N. RIGE, WALWORTH COUNTY, WISCONSIN.





SCALE | " -30 '

LEGEND

O - IRON PIPE FOUND ■ -IRON ROD FOUND)-RECORDED AS

I HEREBY CERTIFY THAT I HAVE SURVEYED THE ABOVE DESCRIBED PROPERTY AND THAT THE ABOVE MAP IS A TRUE REPRESENTATION THEREOF AND SHOWS THE SIZE AND LOCATION OF THE PROPERTY, ITS EXTERIOR BOUNDARIES, THE LOCATION OF ALL VISIBLE STRUCTURES AND DIMENSIONS OF ALL PRINCIPAL BUILDINGS THEREON, BOUNDARY FENCES, APPARENT EASEMENTS, ROADWAYS AND VISIBLE ENCROACHMENTS, IF ANY, TO THE BEST OF MY KNOWLEDGE AND BELIEF.

THIS SURVEY IS MADE FOR THE USE OF THE PRESENT OWNERS OF THE PROPERTY. AND ALSO THOSE WHO PURCHASE, MORTGAGE, OR GUARANTEE THE TITLE THERETO WITHIN ONE (I) YEAR FROM DATE HEREON.

August 2, 1994

DATE JOB NUMBER - NOTE: THIS IS NOT A CERTIFIED COPY UNLESS SEALED.