


KOLB LAND CONSULTING, INC.
LAND SURVEYING • SUBDIVIDING • LAND PLANNING


929 WILLIAMS STREET LAKE GENEVA, WISCONSIN 53147 414 248 3697

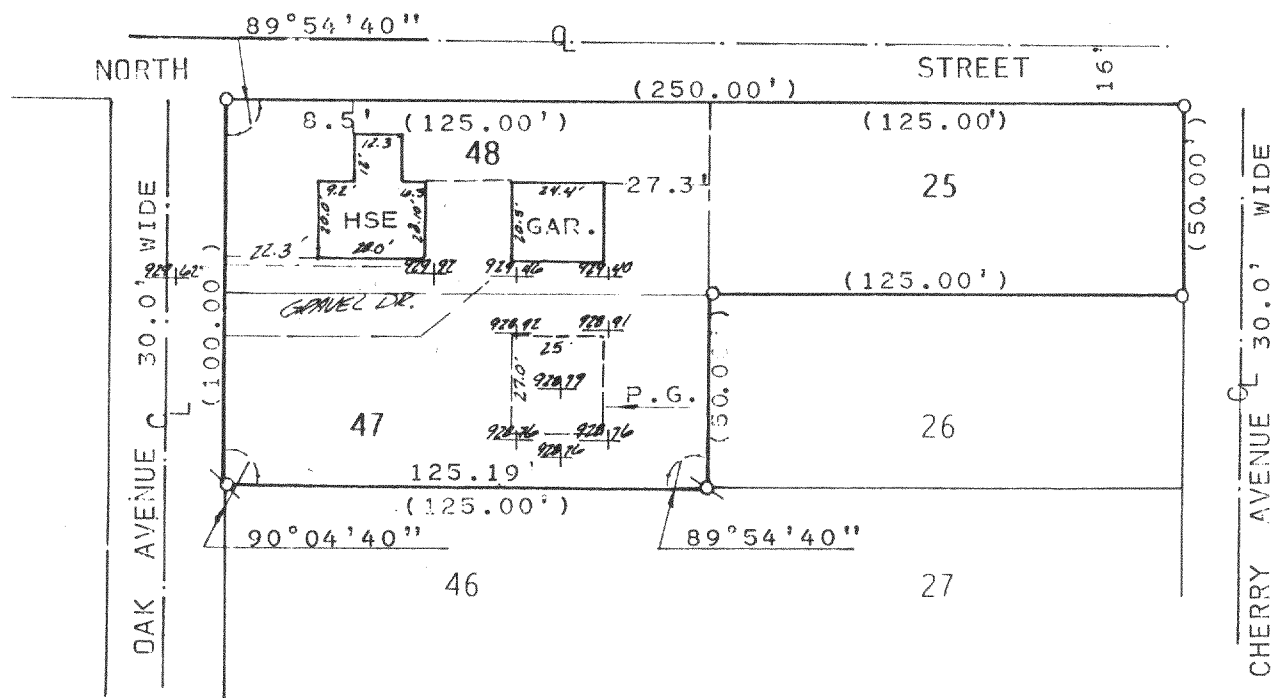

PLAT OF SURVEY OF


LOTS 25, 47 AND 48 OF LAKE DELAVAN HIGH-
LANDS, LOCATED IN T2N, R16E, WALWORTH
COUNTY, WISCONSIN.

ORDERED BY: ELMER WILKS
4407 N WOLCOTT AVE.
CHICAGO, IL. 60640

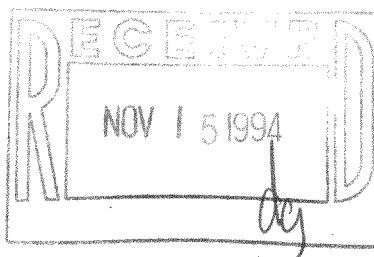

NOTE: FLOOD PLAIN ELEVATION IS 929' PER
FLOOD PLAIN RECORDS ON FILE AT THE
WALWORTH CO. ZONING OFFICE.

NOTE: ELEVATIONS ARE TIED TO DELAVAN LAKE SANITARY DATUM.

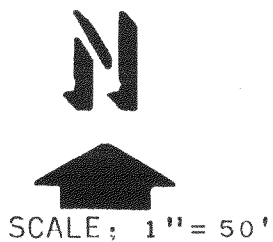

LEGEND

- ⌵ - IRON PIPE FOUND
- - IRON ROD FOUND
- - IRON PIPE SET
- (0.0) - RECORDED AS
- P.G. - PROPOSED GARAGE
- ⊕ - GROUND ELEVATION

I HAROLD H. KOLB, DO HEREBY CERTIFY
THAT I HAVE SURVEYED THE PROPERTY
HEREON DESCRIBED ACCORDING TO THE
OFFICIAL RECORDS, AND THAT THE PLAT
HEREON IS A CORRECT REPRESENTATION
OF THE LOT LINES AND THE PRINCIPAL
BUILDING TO THE BEST OF MY KNOWLEDGE
AND BELIEF. SURVEY NOT VALID UNLESS
SURVEYORS SIGNATURE IS IN RED.

HAROLD H. KOLB

WISCONSIN REGISTERED LAND SURVEYOR, S- 187

DATE JANUARY 6, 1994

REVISED

REVISED

FLAD-22
FLAD-40
FLAD-41

216-1996 2-16-FLAD-22