


RECEIVED  
JAN 13 1995

ORDERED BY: BRADEN & OLSON  
716 WISCONSIN STREET  
LAKE GENEVA, WISCONSIN  
53147

THIS SURVEY IS MADE FOR THE USE OF THE PRESENT OWNERS OF THE PROPERTY AND ALSO THOSE WHO PURCHASE, MORTGAGE OR GUARANTEE THE TITLE THERETO WITHIN ONE (1) YEAR FROM DATE HEREOF.

DATE June 15, 1994 JOB NO. 4267-4

NOTE: THIS IS NOT A CERTIFIED COPY UNLESS SEALED.

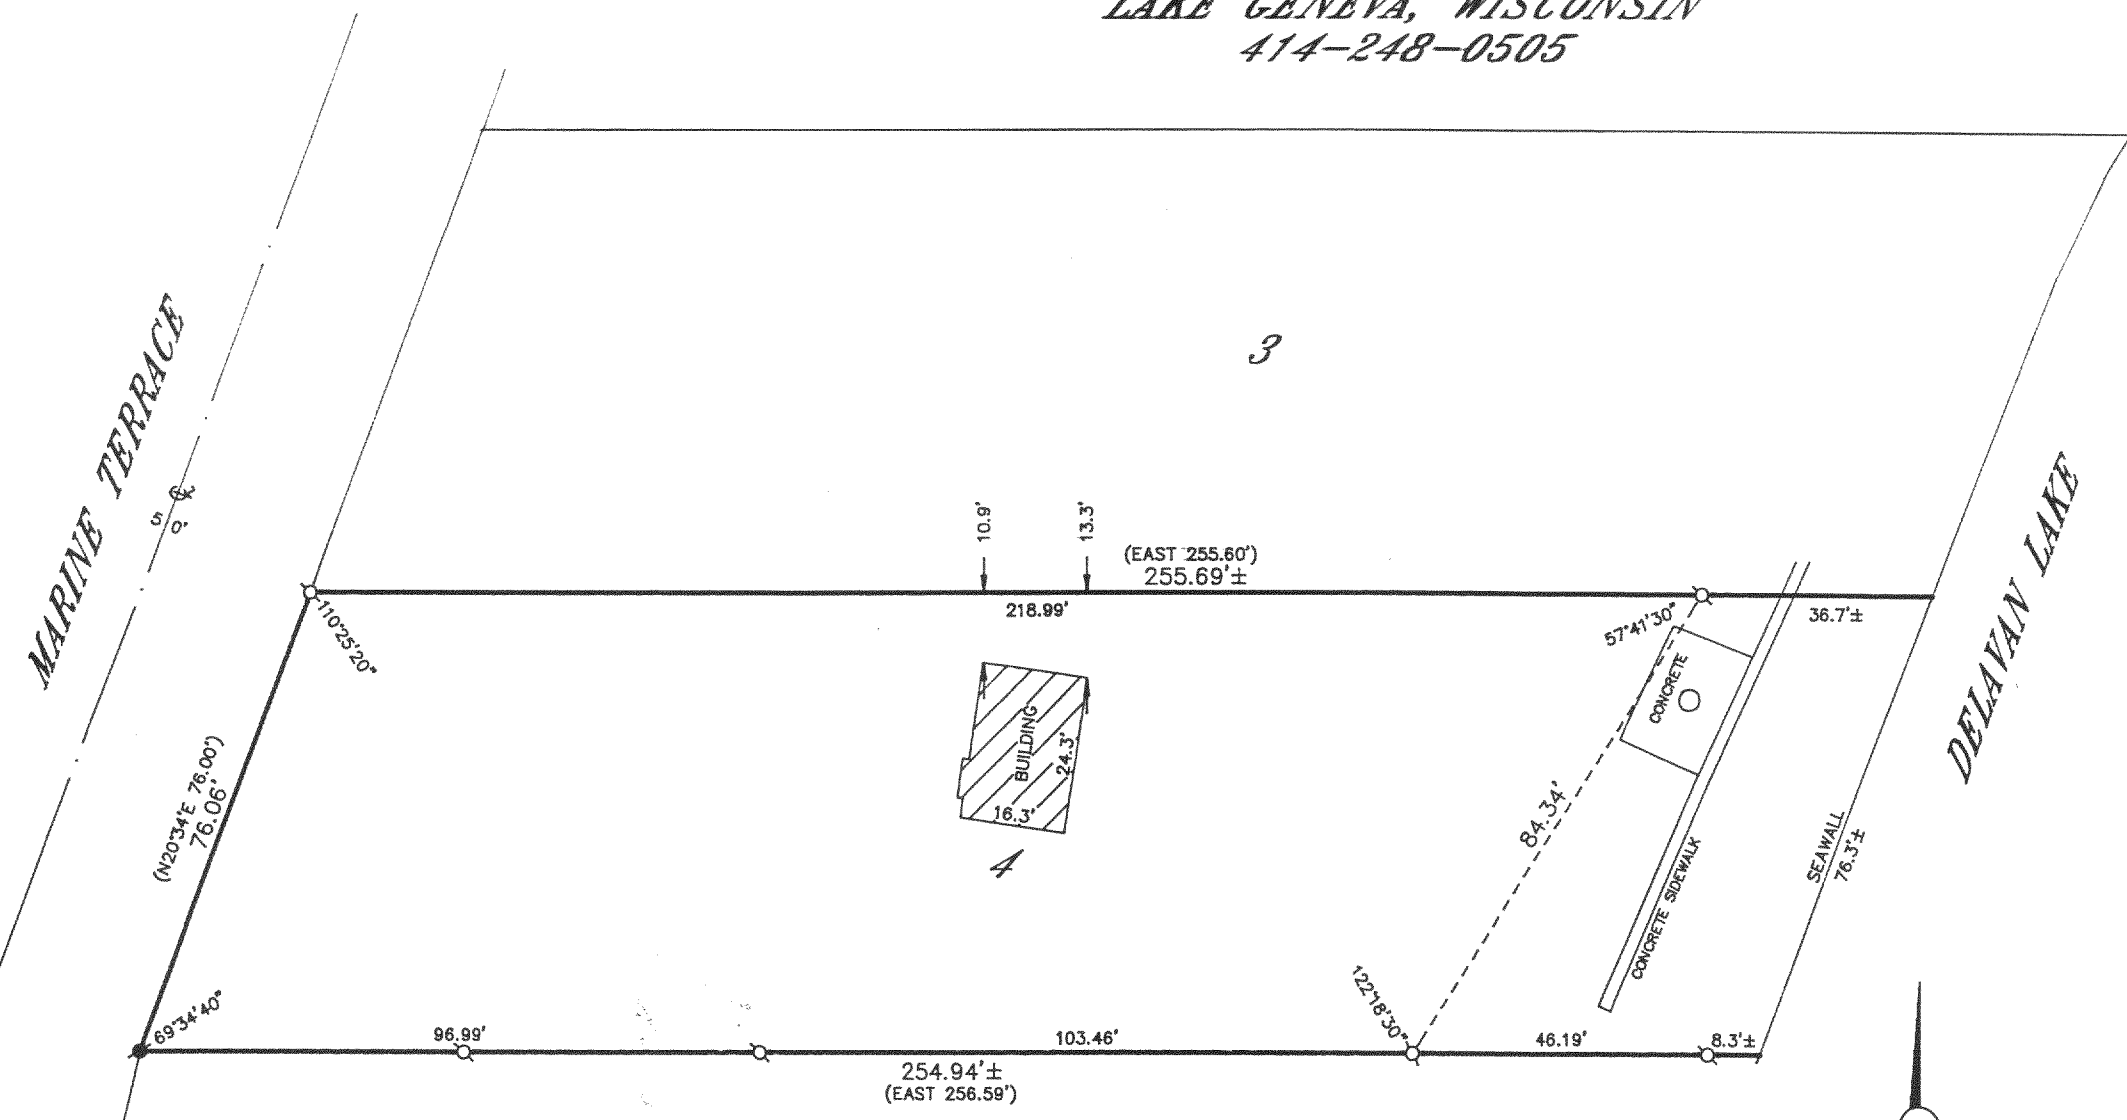

Category	Percentage
1	30
2	0
3	15
4	30
5	60
6	12
7	0
8	0
9	0
10	0
11	0
12	0

Ø-IRON PIPE FOUND  
Ø-IRON ROD FOUND  
●-CONCRETE MONUMENT FOUND  
○-IRON PIPE PLACED  
( )-RECORDED AS

Fwo-4

216-2015