


DUNHAM SURVEYING, S.C.
SURVEYING & SUBDIVIDING
DELAVER, WISCONSIN 53115

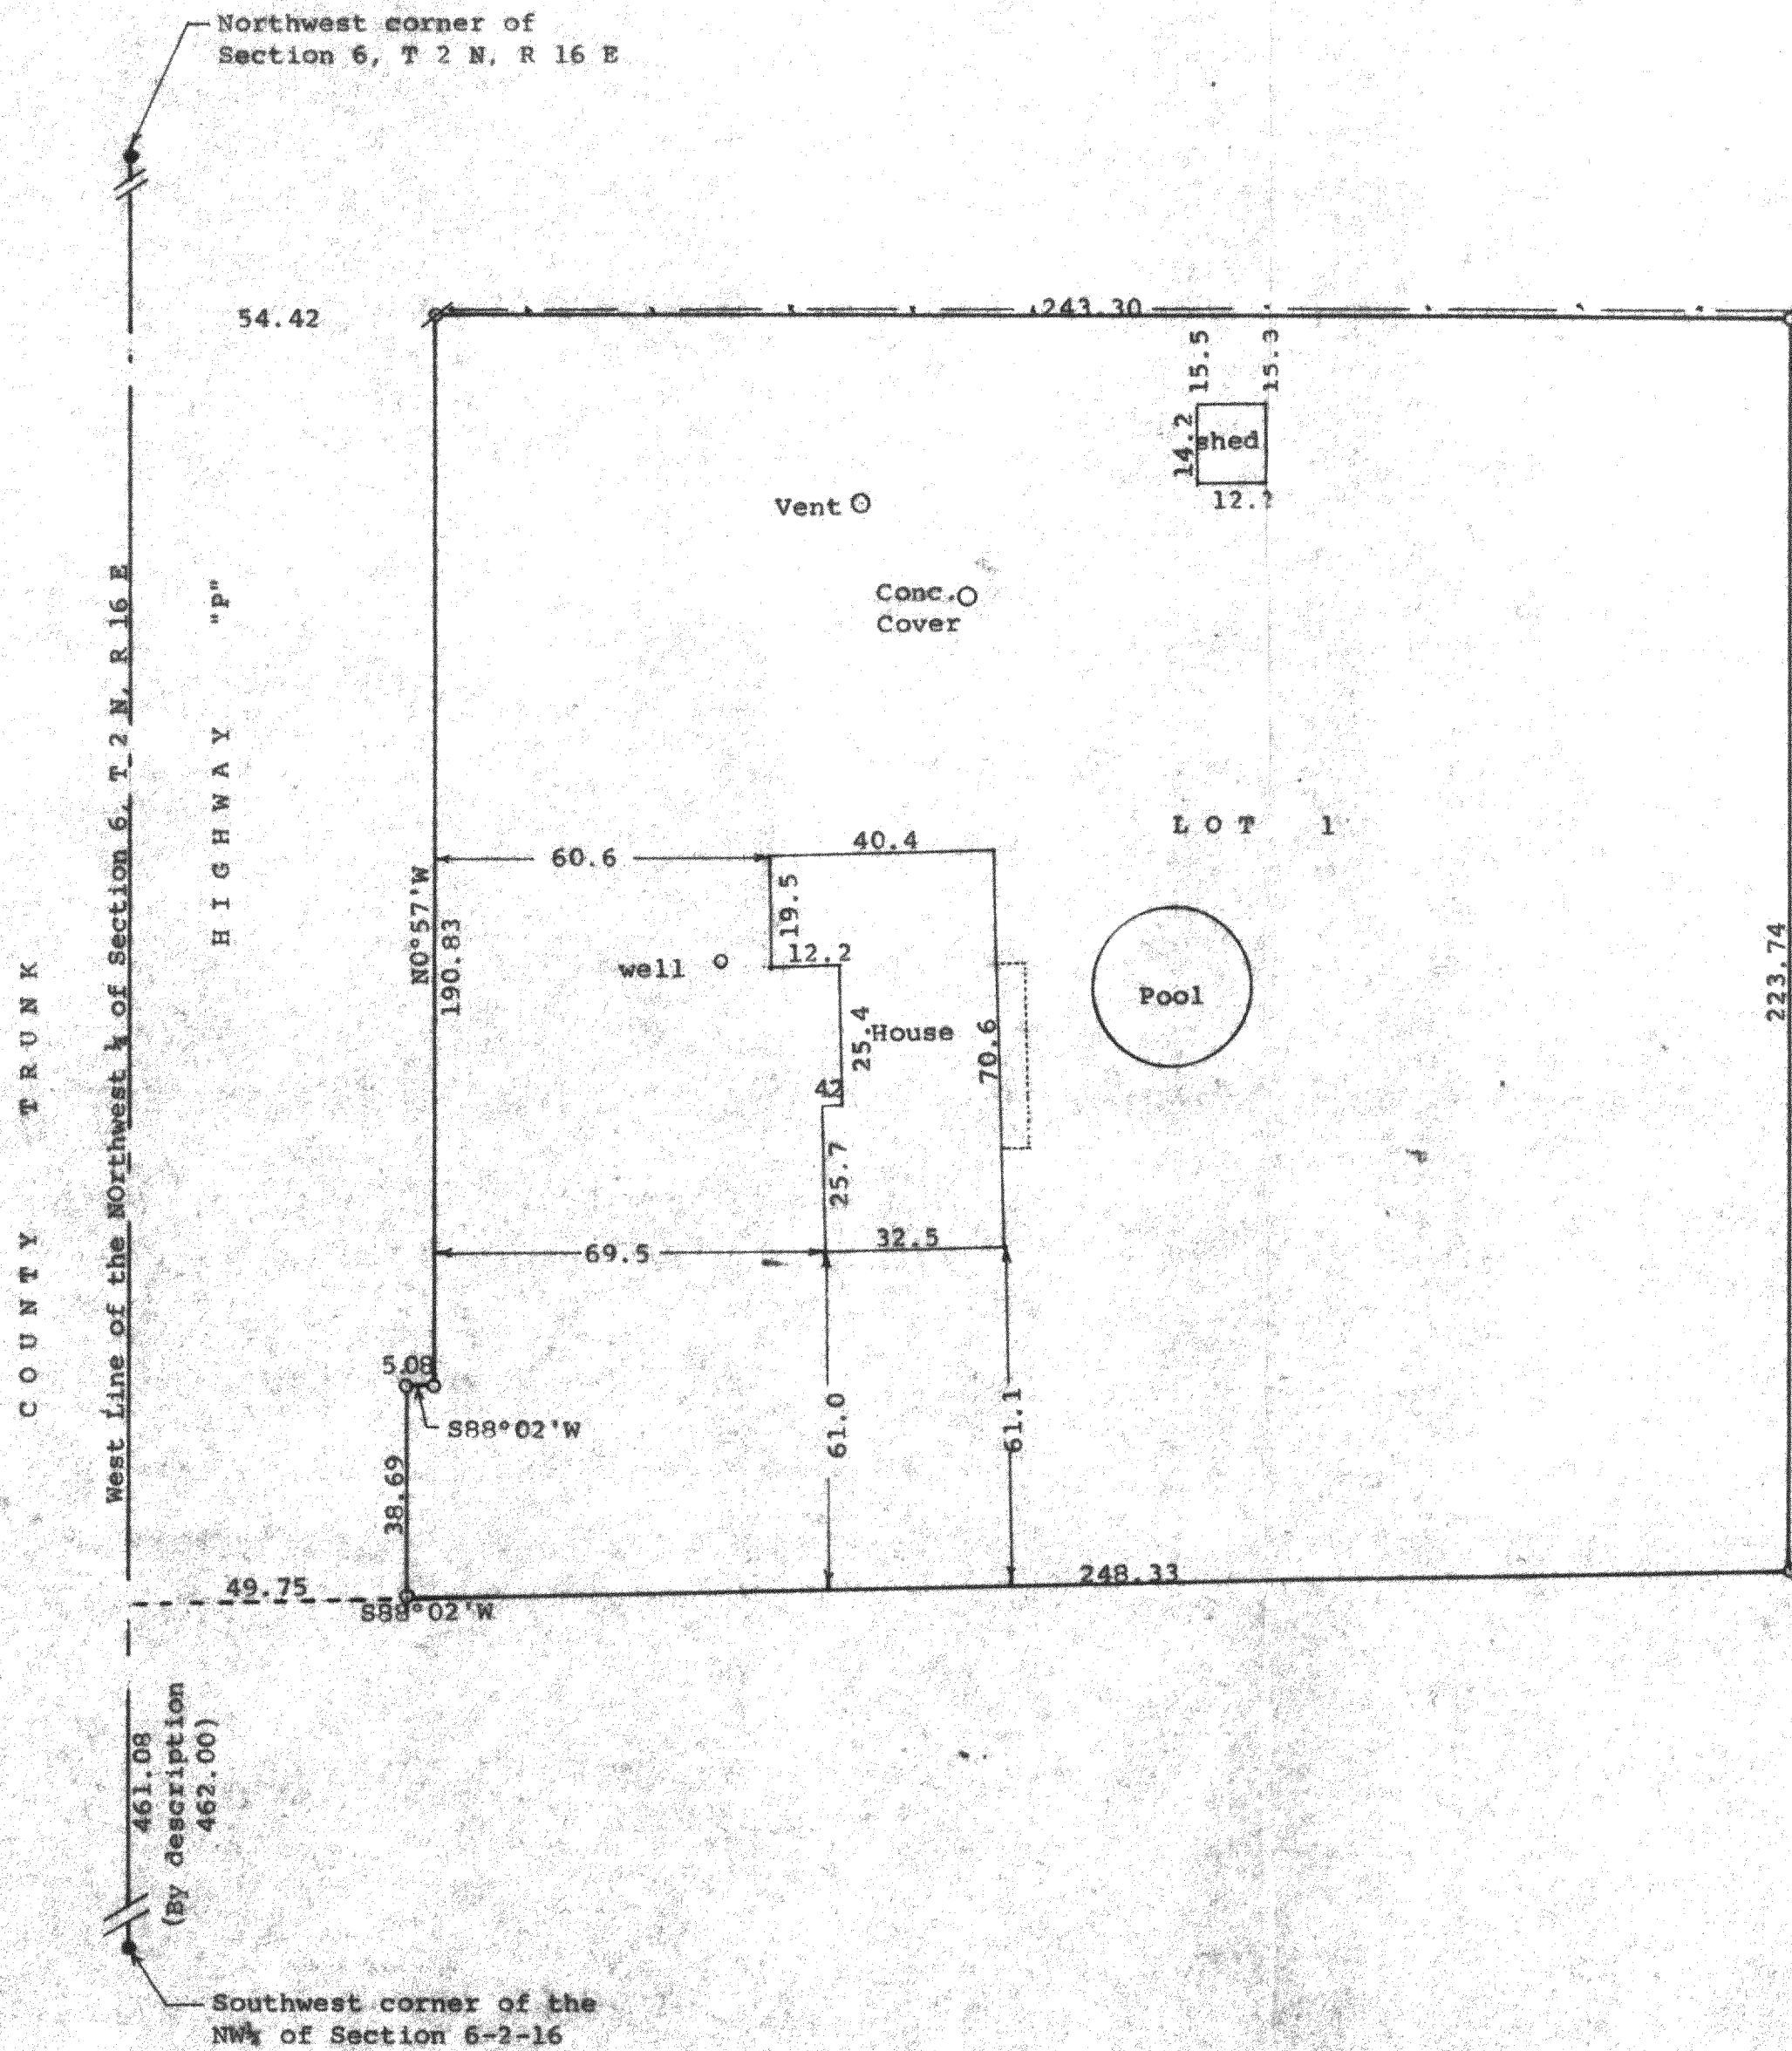

Scale - 1" = 30'
O = 3/4" Iron Pipe Round
Ø = Iron Pipe Found. Size not noted.
Bearings referenced to the south line of Certified Survey No. 144 of S88°02'W.
Survey ordered by: Allen Vegter
678 N. C. T. "P"
DeLavan, WI 53115
--- = Fence Line

STATE OF WISCONSIN)
COUNTY OF WALWORTH) SS
I, George T. Dunham, Surveyor, certify that I have surveyed the property described as follows:
Lot 1 of Certified Survey No. 144 recorded in Volume 1 of Certified Surveys on Page 144, on June 9th, 1972, in the Office of the Register of Deeds, Elkhorn, Wisconsin, being a parcel of land located in the Northwest 1/4 of Section 6, T 2 N, R 16 E, Walworth County, Wisconsin and that the plat shown hereon is a correct representation thereof and shows the size and location of the property, its exterior boundaries, the location of all visible structures and dimensions of all principal buildings thereon, boundary fences, apparent easements, roadways and visible encroachments, if any, and that I have surveyed the property hereon described, according to the official records, to the best of my knowledge and belief.
Survey July 12 & 13, 1993
Plat drawn June 21, 1994

George T. Dunham
George T. Dunham, Surveyor

