

DUNHAM SURVEYING, S.C.
SURVEYING & SUBDIVIDING
DELAVER, WISCONSIN 53115



N

Scale - 1" = 20'
 Ø = 3/4" Iron Pipe Found
 ○ = 3/4" Iron Pipe Set

Bearings referenced to the north line of South Shore Drive with the recorded bearing of 889°29'E

Survey ordered by: Timothy Graham
 P.O. Box 787
 Delavan, WI 53115

STATE OF WISCONSIN)
 COUNTY OF WALWORTH) SS

I, George T. Dunham, Surveyor, certify that I have surveyed the property described as follows:



Lots 191 and 192 in Lake Delavan Highlands, a subdivision located in Section 31, T 2 N, R 16 E, Walworth County, Wisconsin.

ALSO all of that part of Ridge Avenue, (Now Vacated), lying west of and adjoining said lots 191 and 192 of Lake Delavan Highlands, being a parcel of land 30 feet in width, East-West and 100 feet in length, North-South.

and that the plat shown above is a correct representation thereof and shows the size and location of the property, its exterior boundaries, the location of all visible structures and dimensions of all principal buildings thereon, boundary fences, apparent easements, roadways and visible encroachments, if any, and that I have surveyed the property hereon described, according to the official records, to the best of my knowledge and belief.

February 16, 1995

George T. Dunham
 George T. Dunham, Surveyor

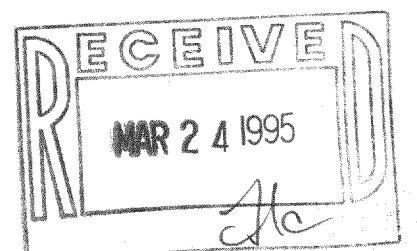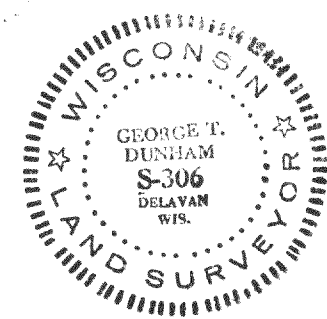

FLAD-148
 FLAD-149, 150

548273

GMB 1020

216-2029