LOT 25 and the WEST 15 FEET OF LOT 24, BLOCK 16, DELMAR SUBDIVISION, a subdivision of part of Government Lot 3, being part of the Southwest 1/4 of the Southwest 1/4, all of the Southeast 1/4 of the Southwest 1/4 and part of the Northeast 1/4 of the Southwest 1/4 of Section 27, Township 2 North, Range 16 East of the 4th Principal Meridian in the Town of Delavan, Walworth County, Wisconsin.

Proposed house was staked on actual corners with 5 foot control on the South house line. The Contractor will be responsible to field verify all stakes for location and dimension prior to construction. If any discrepancies should arise, notify this office at once.

Survey For: Southeast Wisconsin Housing Corp.

of all principal buildings thereon, boundary fences, apparent


"This survey is made for the use of the present owners of the

property, and those who purchase, mortgage, or guarantee the

easements, roadways and encroachments, if any."

FDM-75B

title thereto within one year from date hereof."

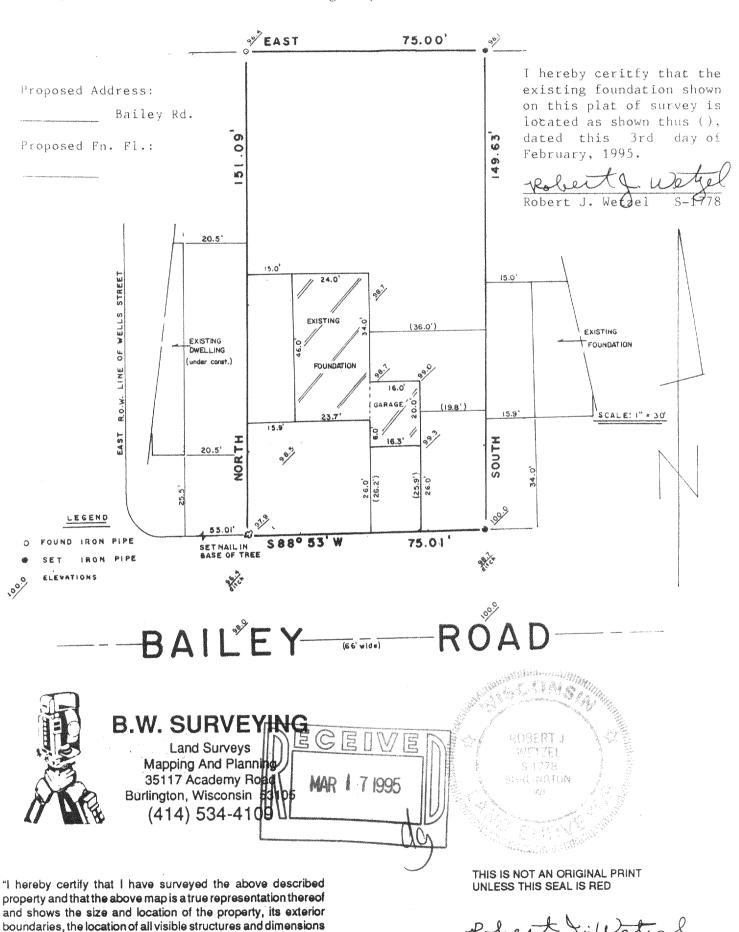

216-2040

ROBERT J. WETZEL

Revised: 11/7/94 REVISED-02/02/95

6/6/94

DATE REVISED 1/29/94

REGISTERED LAND SURVEYOR - 1778


JOB NUMBER REVISED: 12/7/94

1675

LOT 25 and the WEST 15 FEET OF LOT 24, BLOCK 16, DELMAR SUBDIVISION, a subdivision of part of Government Lot 3, being part of the Southwest 1/4 of the Southwest 1/4. all of the Southeast 1/4 of the Southwest 1/4 and part of the Northeast 1/4 of the Southwest 1/4 of Section 27, Township 2 North, Range 16 East of the 4th Principal Meridian in the Town of Delavan, Walworth County, Wisconsin.

Proposed house was staked on actual corners with 5 foot control on the South house line. The Contractor will be responsible to field verify all stakes for location and dimension prior to construction. If any discrepancies should arise, notify this office at once.

Survey For: Southeast Wisconsin Housing Corp.

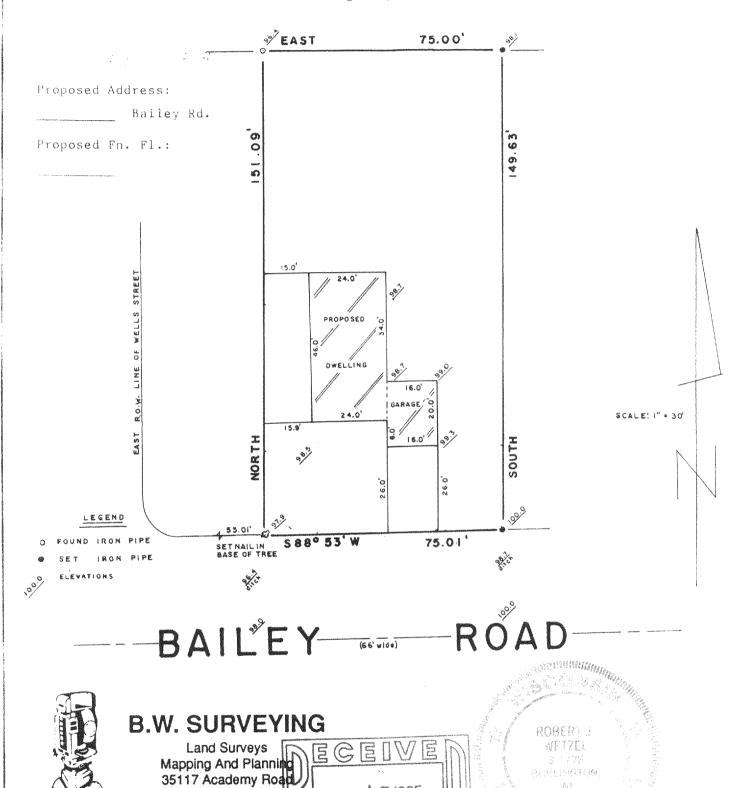

MAR 1-7 1995

"I hereby certify that I have surveyed the above described property and that the above map is a true representation thereof and shows the size and location of the property, its exterior boundaries, the location of all visible structures and dimensions of all principal buildings thereon, boundary fences, apparent easements, roadways and encroachments, if any."

Burlington, Wisconsin 53105 (414) 534-4109

"This survey is made for the use of the present owners of the property, and those who purchase, mortgage, or guarantee the title thereto within one year from date hereof."

THIS IS NOT AN ORIGINAL PRINT UNLESS THIS SEAL IS RED

PELINGFOR

ROBERT J. WETZEL

REGISTERED LAND SURVEYOR - 1778


Rev, sed: 11/7/94

6/6/94 DATE REVISED 11/29/94

1675 JOB NUMBER REVISED: 12/7/94

LOT 25 and the WEST 15 FEET OF LOT 24, BLOCK 16, DELMAR SUBDIVISION, a subdivision of part of Government Lot 3, being part of the Southwest 1/4 of the Southwest 1/4, all of the Southwest 1/4 of the Southwest 1/4 and part of the Northeast 1/4 of the Southwest 1/4 of Section 27, Township 2 North, Range 16 East of the 4th Principal Meridian in the Town of Delavan, Walworth County, Wisconsin.

Survey For: Southeastern Wisconsin Housing Corp.

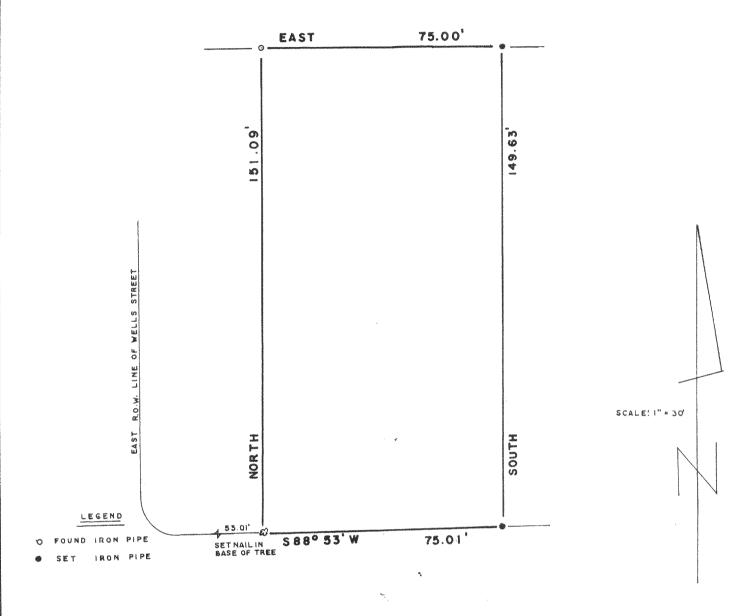


---BAILEY (66' WIOO) ROAD



B.W. SURVEYING

Land Surveys
Mapping And Planning
35117 Academy Road
Burlington, Wisconsin 53105
(414) 534-4109



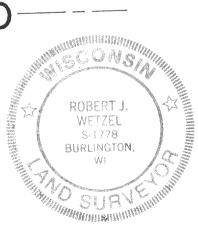

THIS IS NOT AN ORIGINAL PRINT UNLESS THIS SEAL IS RED

"I hereby certify that I have surveyed the above described property and that the above map is a true representation thereof and shows the size and location of the property, its exterior boundaries, the location of all visible structures and dimensions of all principal buildings thereon, boundary fences, apparent easements, roadways and encroachments, if any."

"This survey is made for the use of the present owners of the property, and those who purchase, mortgage, or guarantee the title thereto within one year from date hereof."

ROBERT J. WETZEL
REGISTERED LAND SURVEYOR - 1778

,6/6/94 DATE

JOB NUMBER