

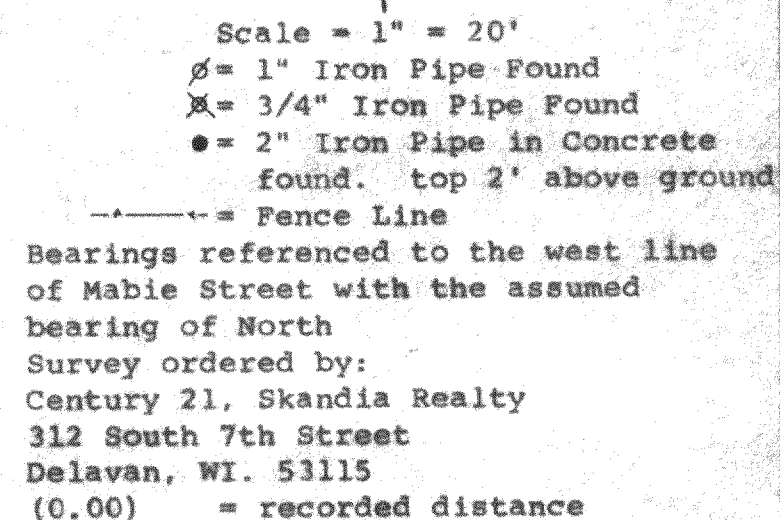


SURVEYING & SUBDIVIDING
DELA VAN, WISCONSIN 53115

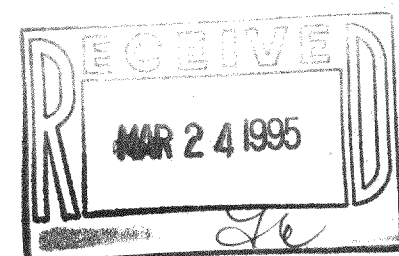


George T. Dunham, Surveyor

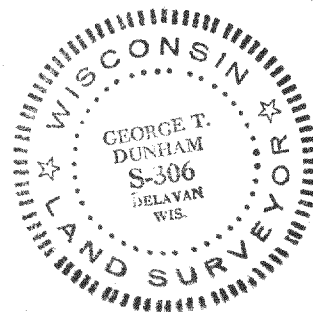

FDM-54A

216-2053