


DUNHAM SURVEYING, S. C.  
 SURVEYING & SUBDIVIDING  
 DELAVAN, WISCONSIN 53115



Scale - 1" = 20'

- ⊙ = 1/2" Iron Pipe Found
- ⊗ = 3/4" Iron Pipe Found
- ⊖ = 1" Iron Pipe Set
- = 3/4" Iron Pipe Set

(0.00) = recorded distance  
 Bearings referenced to the recorded bearing  
 S89°29'E along the south line of the plat  
 of Lake Delavan Highlands  
 Survey ordered by:  
 The Rauland Agency  
 118 Kenosha  
 Walworth, WI 53184  
 ⊕ = 1 1/4" Iron Pipe Found

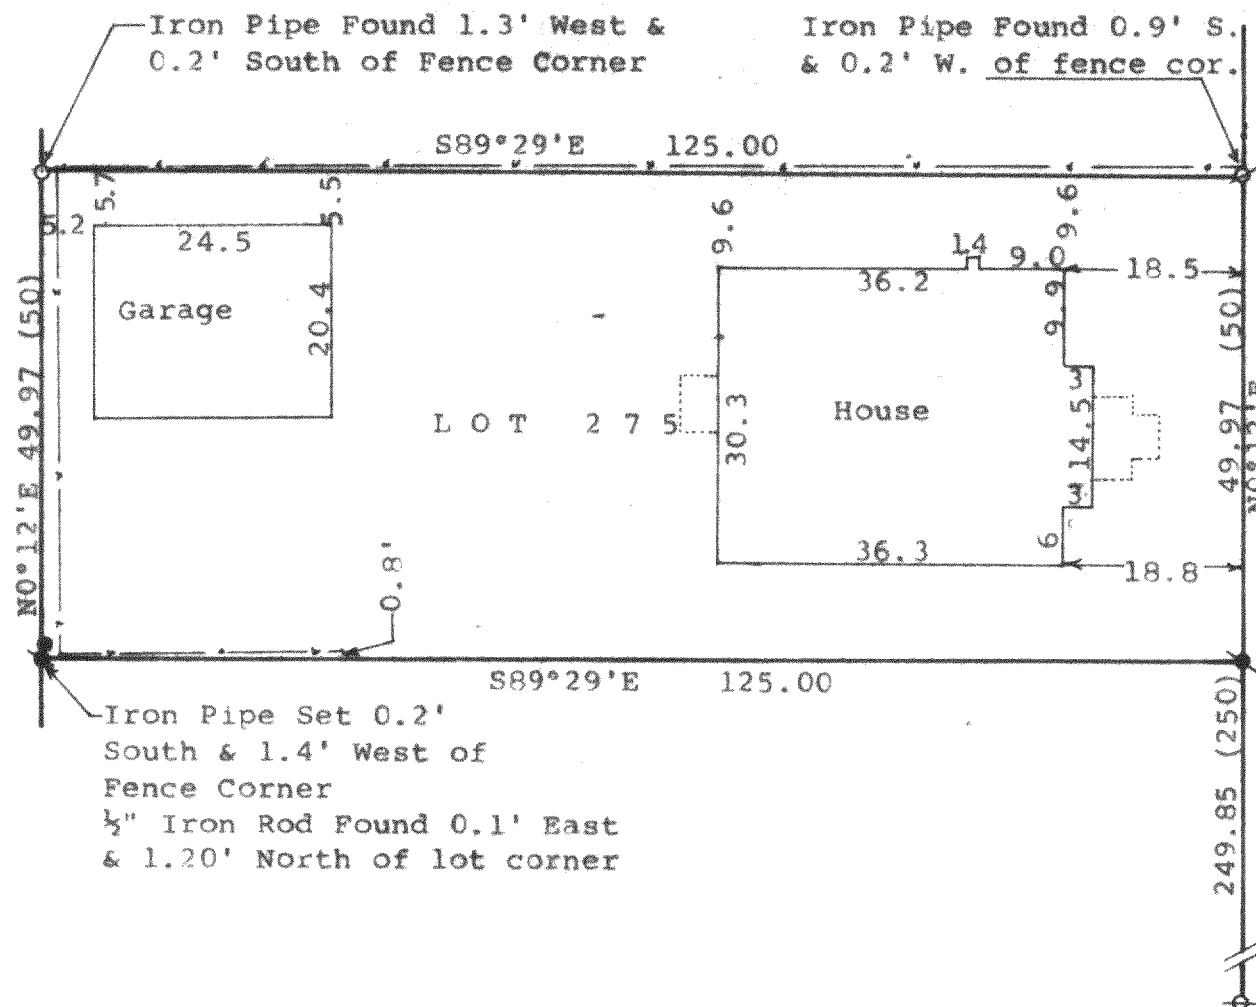

STATE OF WISCONSIN)ss  
 COUNTY OF WALWORTH)



I, George T. Dunham, Surveyor, certify that I have surveyed the property described as follows:

Lot 275 in Lake Delavan Highlands, a subdivision located in Section 31, T 2 N, R 16 E, Walworth County, Wisconsin

and that the plat shown hereon is a correct representation thereof and shows the size and location of the property, its exterior boundaries, the location of all visible structures and dimensions of all principal buildings thereon, boundary fences, apparent easements, roadways and visible encroachments, if any, and that I have surveyed the property hereon described, according to the official records, to the best of my knowledge and belief.

March 28, 1994.

*George T. Dunham*  
 George T. Dunham, Surveyor

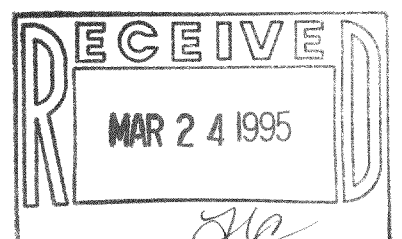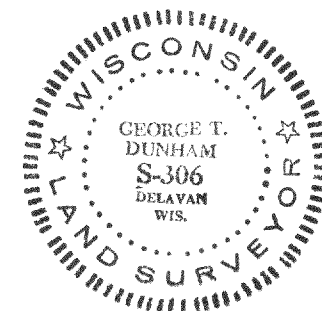

FLAD-209

216-2057