




**ABELL
SURVEYING & MAPPING
DELAVAN, WISCONSIN 53115
414-728-6737**

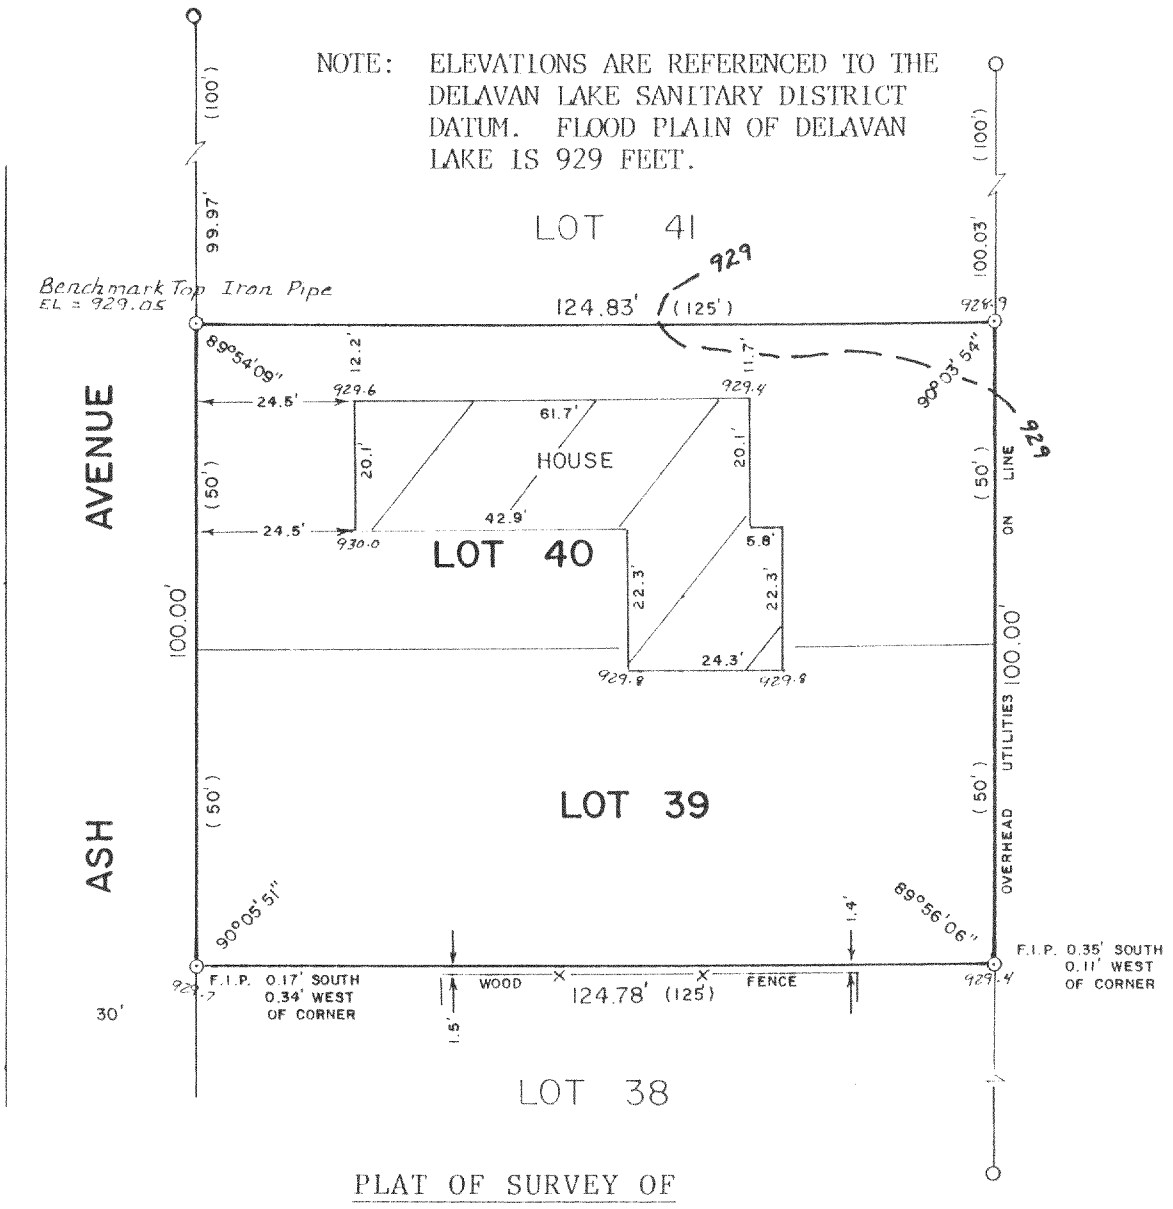

PLAT OF SURVEY OF

LOTS 39 AND 40, LAKE DELAVAN HIGHLANDS,
T2N,R16E, WALWORTH COUNTY, WISCONSIN.

ORDERED BY: STEBNITZ BUILDERS
1102 ANN STREET
DELAVAN, WI 53115

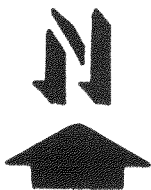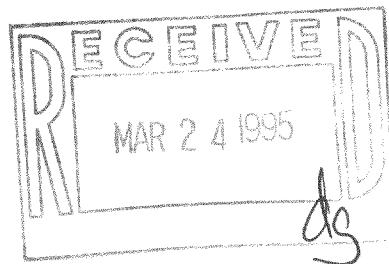

SCALE - 1"=30'

LEGEND

- - IRON PIPE FOUND
- () - RECORDED AS
- 929.6 - GROUND ELEVATION

I, DAVID F. ABELL, DO HEREBY CERTIFY THAT I HAVE SURVEYED THE PROPERTY HEREON DESCRIBED ACCORDING TO THE OFFICIAL RECORDS AND THAT THE PLAT HEREON IS A CORRECT REPRESENTATION OF THE PROPERTY LINES TO THE BEST OF MY KNOWLEDGE AND BELIEF.

David F. Abell
DAVID F. ABELL

WISCONSIN REGISTERED LAND SURVEYOR, S-1596

January 18, 1995 REVISED: 2/2/95
DATE JOB NUMBER - 95004

NOTE: THIS IS NOT A CERTIFIED COPY UNLESS SEALED.

FLAD-34
FLAD-35

216-2059