


**SURVEYING & SUBDIVIDING  
DELAN, WISCONSIN 53115**

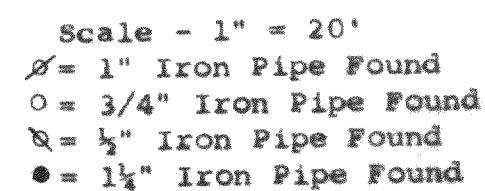

STATE OF WISCONSIN)  
COUNTY OF WALWORTH) SS

Lots 14 and 15, Block 1 of The Inlet Oaks, a subdivision located in Section 22, T 2 N, R 16 E, Walworth County, Wisconsin

May 10. 1991

Revised May 21, 1991

Sergei Dunham

