
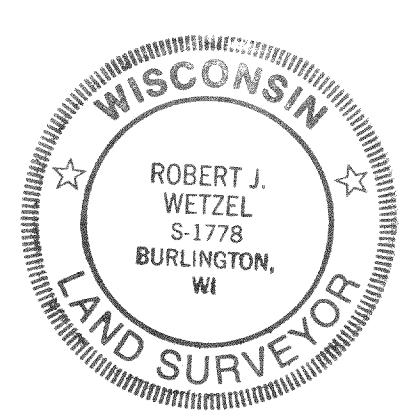



PLAT OF SURVEY
-OF-

A PARCEL OF LAND LOCATED IN THE NORTHEAST 1/4 OF FRACTIONAL SECTION 22, TOWNSHIP 2 NORTH, RANGE 16 EAST OF THE FOURTH PRINCIPAL MERIDIAN, IN THE TOWN OF DELAVAN, WALWORTH COUNTY, WISCONSIN, DESCRIBED AS FOLLOWS: COMMENCING AT THE EAST 1/4 SECTION CORNER OF SAID SECTION 22; THENCE WEST ALONG THE 1/4 SECTION LINE 38.14 FEET TO THE PLACE OF BEGINNING; THENCE CONTINUE WEST ON THE 1/4 SECTION LINE 191.71 FEET TO A POINT IN THE CENTERLINE OF STATE TRUNK HIGHWAY NO. 50; THENCE NORTH 29°20' WEST ALONG SAID CENTERLINE 106.29 FEET TO A POINT; THENCE NORTH 38°43' EAST 198.87 FEET TO A POINT; THENCE SOUTH 25°45' EAST 274.91 FEET TO SAID 1/4 SECTION LINE AND THE PLACE OF BEGINNING.

SURVEY FOR: DON SCHULTZ
SURVEY LOCATION: 102 S.T.H. "50"

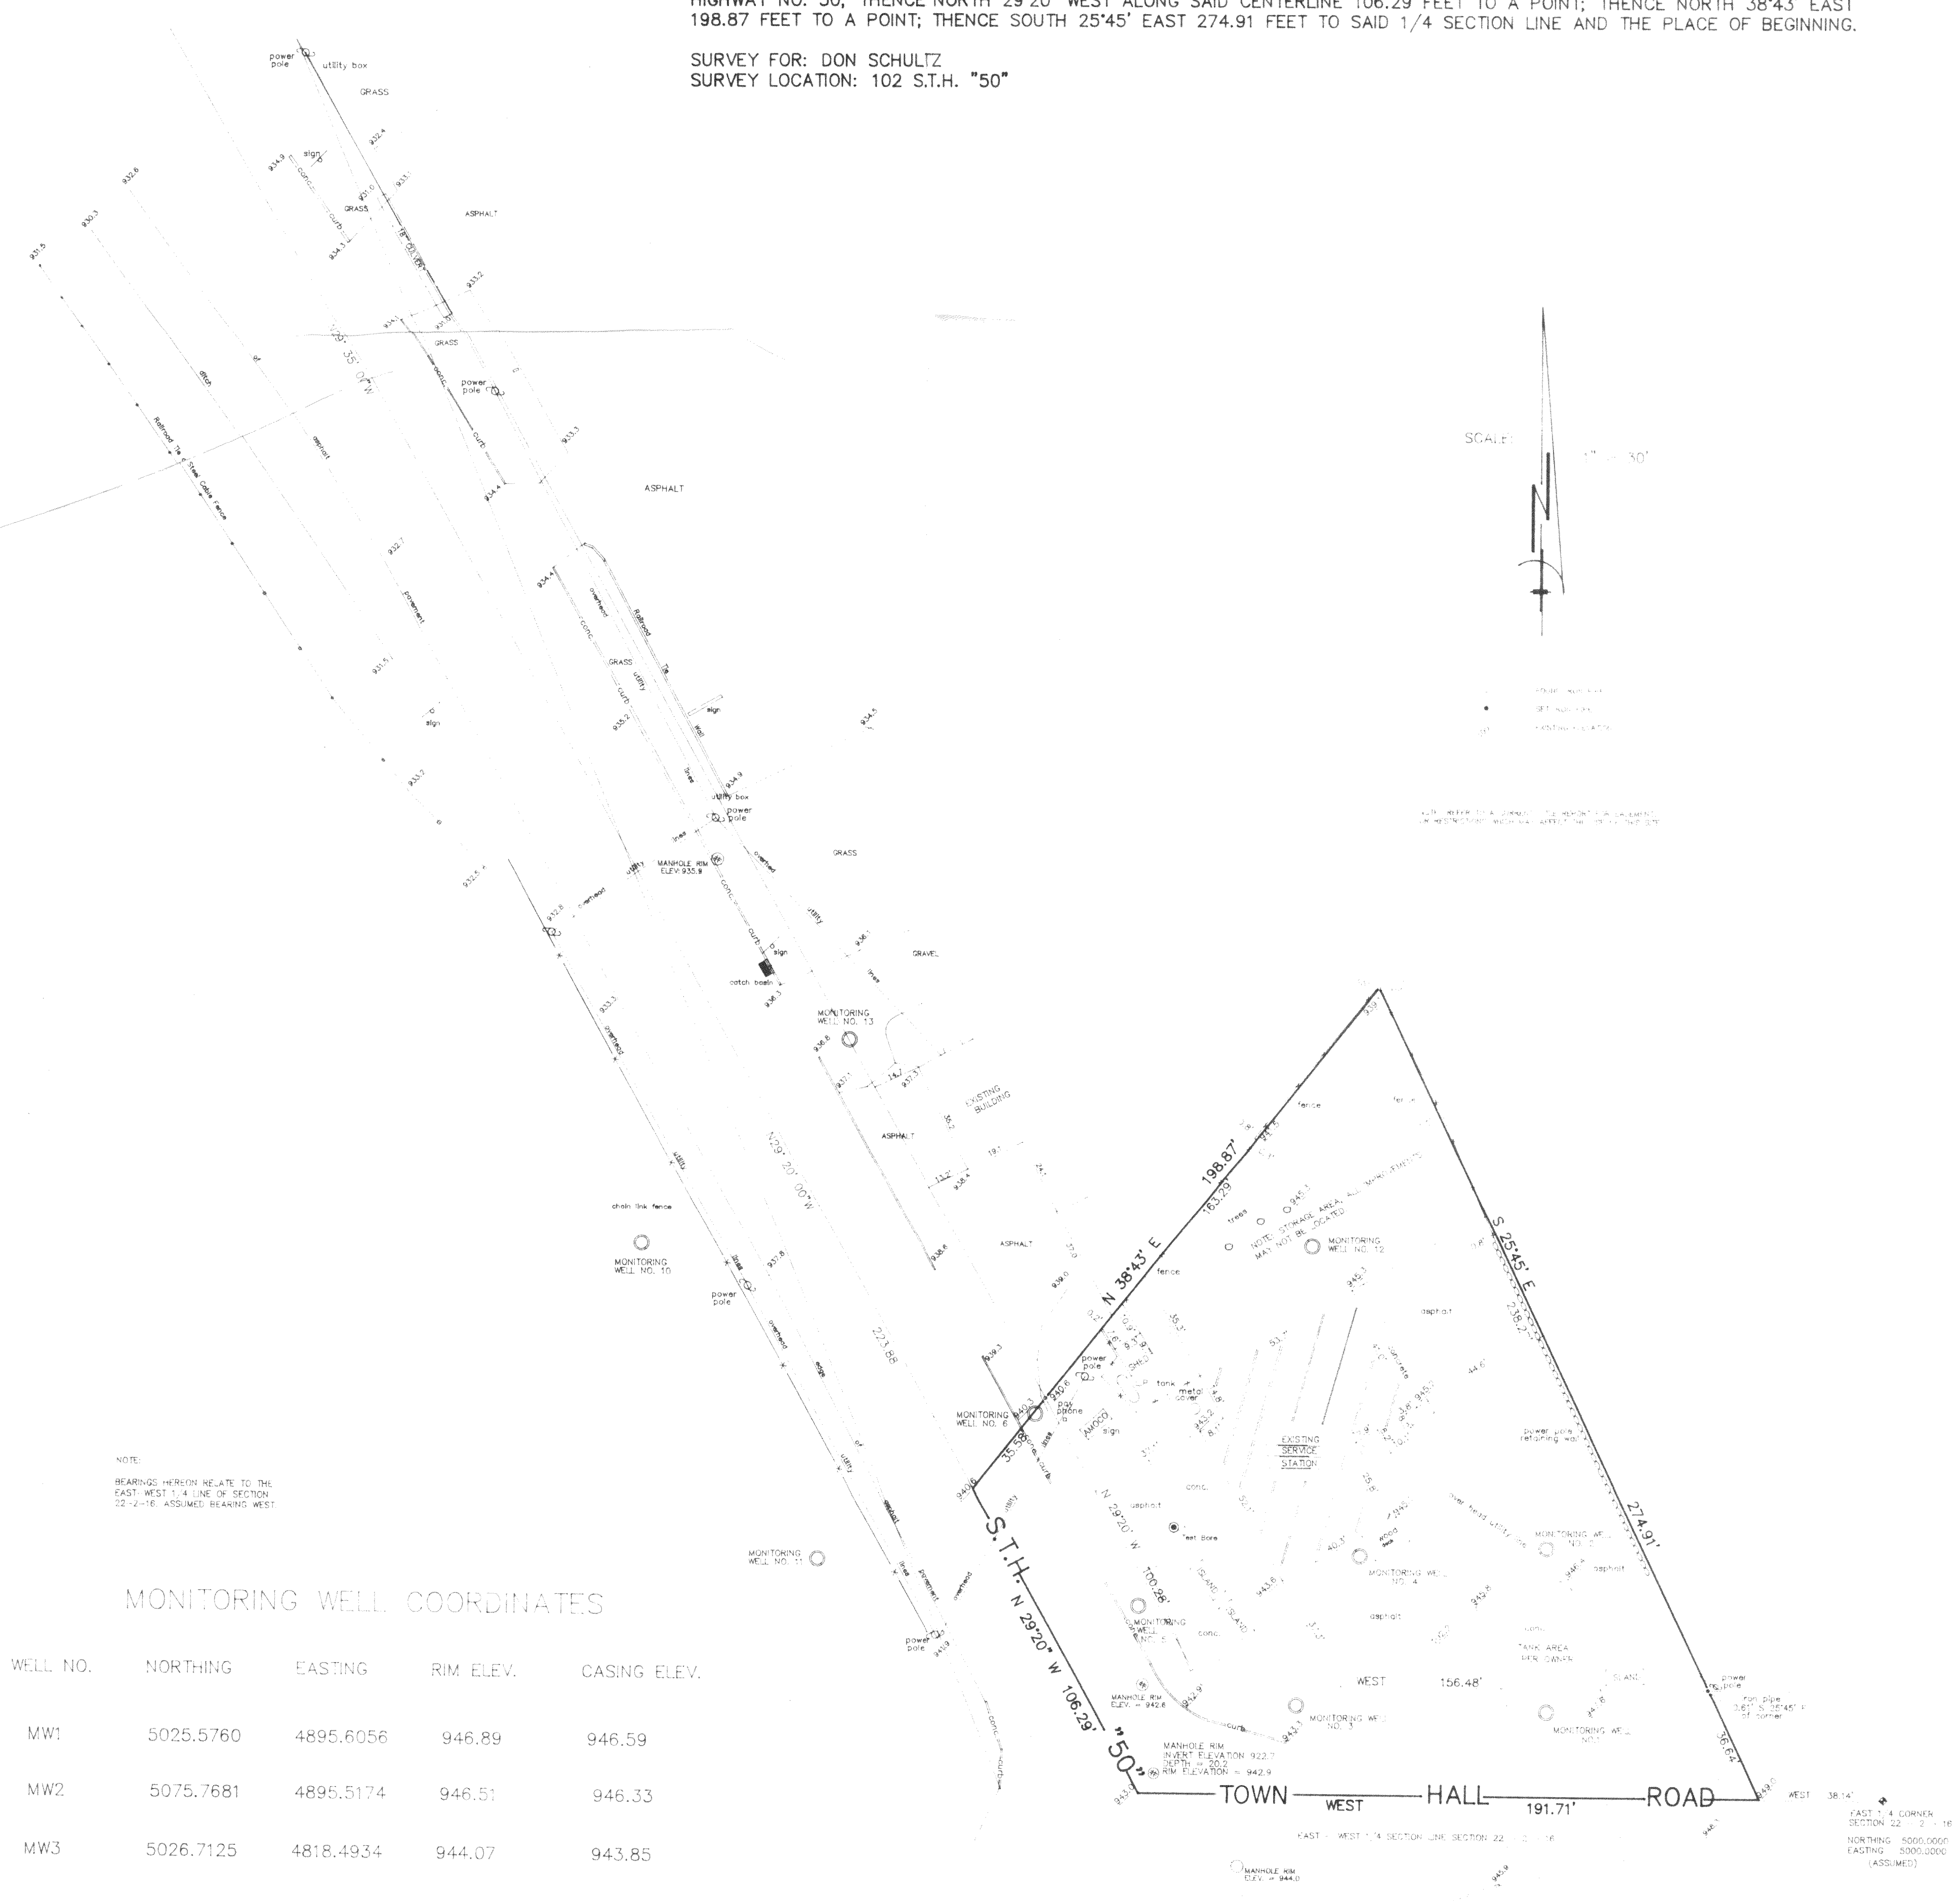

Robert J. Wetzel
S-1778

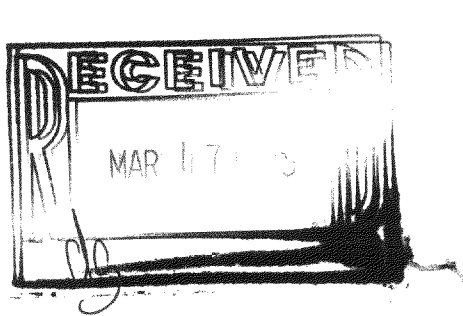

B.W. SURVEYING
35117 ACADEMY ROAD
BURLINGTON, WI 53105
(414)-534-4109

DRAWN BY:	BW	DATE:	REVISED: 9-27-94 AUGUST 19, 1994
CHECKED BY:	BW	DRAWING NO.:	1768d2
JOB NO.:	1768	SHEET	1 OF 1