

417 120 510

15/ LOT 22

(EAST 135')  
135.03'

FOUND IRON PIPE 0 10'  
EAST OF LINE

90°00'55" 25.85'

60.15' (60')

80.15'

90°00'55" 10.7'

26.1'

GARAGE

LOT 21

18.4'

3.8'

28.5'

18.8'

41.1'

HOUSE

16.3'

24.5'

4.2'

26.6'

FOUNDATION OF NEW  
ADDITION

39.4'

18.7'

11.5'

14.8'

15.6'

GRAVEL DRIVE

WELL

38.8'

80°56'00"

60.00'

80.00' (NORTH)

20.00'

90°07'40"

134.96'

LOT 20

NORTH 20' OF  
LOT 20

20.00'

89°55'25"

BLOCK

STREET

WELLS

5 0'

DETAIL

0.7'

9.4'

1.5'

WOOD FENCE


SCALE · 1" = 10'

## PLAT OF SURVEY OF

LOT 21 AND THE NORTH 20 FEET OF LOT 20, BLOCK 15,  
DELMAR SUBDIVISION, T2N,R16E, WALWORTH COUNTY,  
WISCONSIN.

ORDERED BY: SHARI GRICE  
ROUTE 3, BOX 303  
DEHAVAN, WI. 53115

REVISED: MAY 23, 1995 TO SHOW THE LOCATION OF THE FOUNDATION OF  
THE NEW ADDITION. ORDERED BY: SHARI WISNIEWSKI  
3001 WELLS ST.  
DELAVER, WI 53115

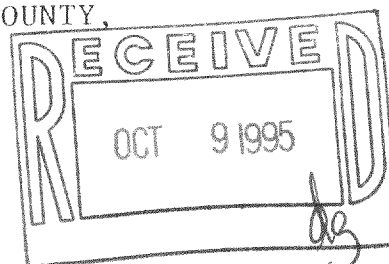

### LEGEND

- LEGEND
- Ø - IRON PIPE FOUND  
○ - IRON PIPE SET  
( ) - RECORDED AS

I, DAVID F. ABELL, DO HEREBY CERTIFY THAT I HAVE SURVEYED THE PROPERTY HEREON DESCRIBED ACCORDING TO THE OFFICIAL RECORDS AND THAT THE PLAT HEREON IS A CORRECT REPRESENTATION OF THE PROPERTY LINES TO THE BEST OF MY KNOWLEDGE AND BELIEF.

David F. Abell

DAVID F. ABELL  
WISCONSIN REGISTERED LAND SURVEYOR, S-1596

DATE April 10, 1989 JC

JOB NUMBER - 89044

NOTE: THIS IS NOT A CERTIFIED COPY UNLESS SEALED.

FDM-66E

216-2148