

**ABELL**  
**SURVEYING & MAPPING**  
 DELAVAN, WISCONSIN 53115  
 414-728-6737



SCALE 1" = 20'  
 LEGEND

- ⊙ - IRON PIPE FOUND
- \* - WOOD FENCE
- ▲ - LAMP POST
- CS - CONCRETE STOOP
- ( ) - RECORDED AS

**BLOCK**

NOTE: BEARINGS ARE REFERENCED TO THE RECORDED SUBDIVISION PLAT.


ORDERED BY: PROFESSIONAL REALTY  
 1155 E. GENEVA STREET  
 DELAVAN, WI 53115

I HEREBY CERTIFY THAT I HAVE SURVEYED THE ABOVE DESCRIBED PROPERTY AND THAT THE ABOVE MAP IS A TRUE REPRESENTATION THEREOF AND SHOWS THE SIZE AND LOCATION OF THE PROPERTY, ITS EXTERIOR BOUNDARIES, THE LOCATION OF ALL VISIBLE STRUCTURES AND DIMENSIONS OF ALL PRINCIPAL BUILDINGS THEREON, BOUNDARY FENCES, APPARENT EASEMENTS, ROADWAYS AND VISIBLE ENCROACHMENTS, IF ANY, TO THE BEST OF MY KNOWLEDGE AND BELIEF.

THIS SURVEY IS MADE FOR THE USE OF THE PRESENT OWNERS OF THE PROPERTY, AND ALSO THOSE WHO PURCHASE, MORTGAGE, OR GUARANTEE THE TITLE THERETO WITHIN ONE (1) YEAR FROM DATE HEREON.

**PLAT OF SURVEY OF**

LOT 29, BLOCK 15, DELMAR SUBDIVISION,  
 LOCATED IN T2N, R16E, WALWORTH COUNTY,  
 WISCONSIN.

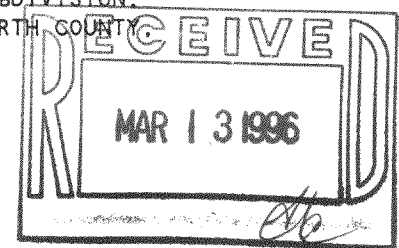

*David F. Abell*

DAVID F. ABELL  
 WISCONSIN REGISTERED LAND SURVEYOR, S-1596

*August 31, 1995*

DATE: \_\_\_\_\_ JOB NUMBER - 95150  
 NOTE: THIS IS NOT A CERTIFIED COPY UNLESS SEALED.

FDM-680

216-2203