

ABELL  
SURVEYING & MAPPING  
DELAVER, WISCONSIN 53115  
414-728-6737



SCALE 1"=20'

LEGEND

- Ø - IRON PIPE FOUND
- \* - WOOD FENCE
- ▲ - LAMP POST
- CS - CONCRETE STOOP
- ( ) - RECORDED AS


BLOCK

NOTE: BEARINGS ARE REFERENCED TO THE  
RECORDED SUBDIVISION PLAT.

ORDERED BY: PROFESSIONAL REALTY  
1155 E. GENEVA STREET  
DELAVER, WI 53115

**PLAT OF SURVEY OF**

LOT 29, BLOCK 15, DELMAR SUBDIVISION,  
LOCATED IN T2N, R16E, WALWORTH COUNTY,  
WISCONSIN.

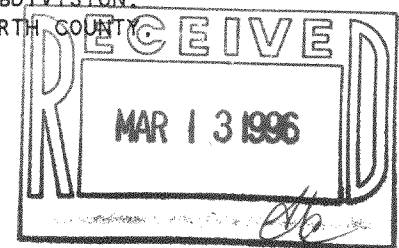

I HEREBY CERTIFY THAT I HAVE SURVEYED THE ABOVE DESCRIBED PROPERTY AND THAT THE ABOVE MAP IS A TRUE REPRESENTATION THEREOF AND SHOWS THE SIZE AND LOCATION OF THE PROPERTY, ITS EXTERIOR BOUNDARIES, THE LOCATION OF ALL VISIBLE STRUCTURES AND DIMENSIONS OF ALL PRINCIPAL BUILDINGS THEREON, BOUNDARY FENCES, APPARENT EASEMENTS, ROADWAYS AND VISIBLE ENCROACHMENTS, IF ANY, TO THE BEST OF MY KNOWLEDGE AND BELIEF.

THIS SURVEY IS MADE FOR THE USE OF THE PRESENT OWNERS OF THE PROPERTY, AND ALSO THOSE WHO PURCHASE, MORTGAGE, OR GUARANTEE THE TITLE THERETO WITHIN ONE (1) YEAR FROM DATE HEREON.

*David F. Abell*

DAVID F. ABELL  
WISCONSIN REGISTERED LAND SURVEYOR, S-1596

*August 31, 1995*

DATE: *August 31, 1995* JOB NUMBER - 95150  
NOTE: THIS IS NOT A CERTIFIED COPY UNLESS SEALED.

FDM-680

216-2203