
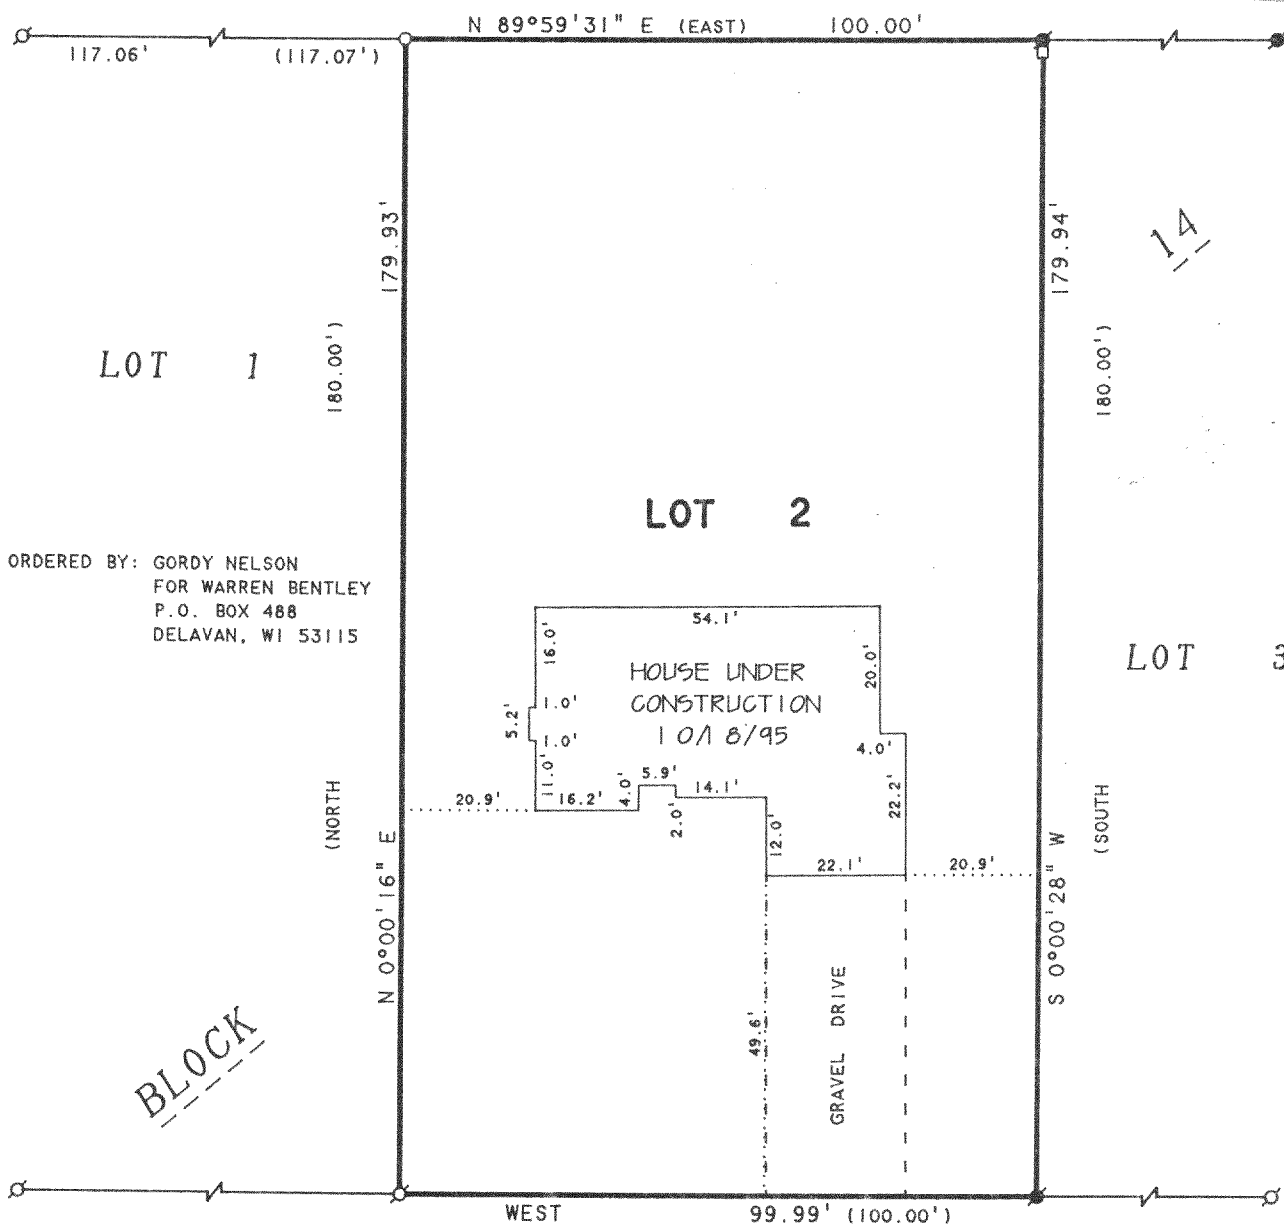


EXTRA Copy

ABELL
SURVEYING & MAPPING
DELAVAN, WISCONSIN 53115
414-728-6737

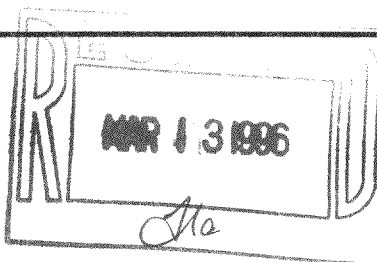

VALENCIA DRIVE

NOTE: BEARINGS ARE REFERENCED TO THE
RECORDED SUBDIVISION PLAT.

PLAT OF SURVEY OF

LOT 2, BLOCK 14, INLET OAKS SUBDIVISION NO. 5,
LOCATED IN T2N, R16E, WALWORTH COUNTY, WISCONSIN.

N



SCALE 1"=30'

LEGEND

- - IRON PIPE FOUND
- - IRON ROD FOUND
- - IRON ROD SET, found 10/18/95
- - UTILITY PED.
- () - RECORDED AS

I, DAVID F. ABELL, DO HEREBY CERTIFY THAT I HAVE SURVEYED THE PROPERTY HEREON
DESCRIBED ACCORDING TO THE OFFICAL RECORDS AND THAT THE PLAT HEREON IS A
CORRECT REPRESENTATION OF THE PROPERTY LINES TO THE BEST OF MY KNOWLEDGE AND
BELIEF.

David F. Abell

DAVID F. ABELL
WISCONSIN REGISTERED LAND SURVEYOR, S-1596

August 23, 1995 REVISED DATE OCTOBER 18, 1995



DATE JOB NUMBER - 95145

NOTE: THIS IS NOT A CERTIFIED COPY UNLESS SEALED.

FIN5-40

216-2212

ABELL
SURVEYING & MAPPING
DELAVER, WISCONSIN 53115
414-728-6737

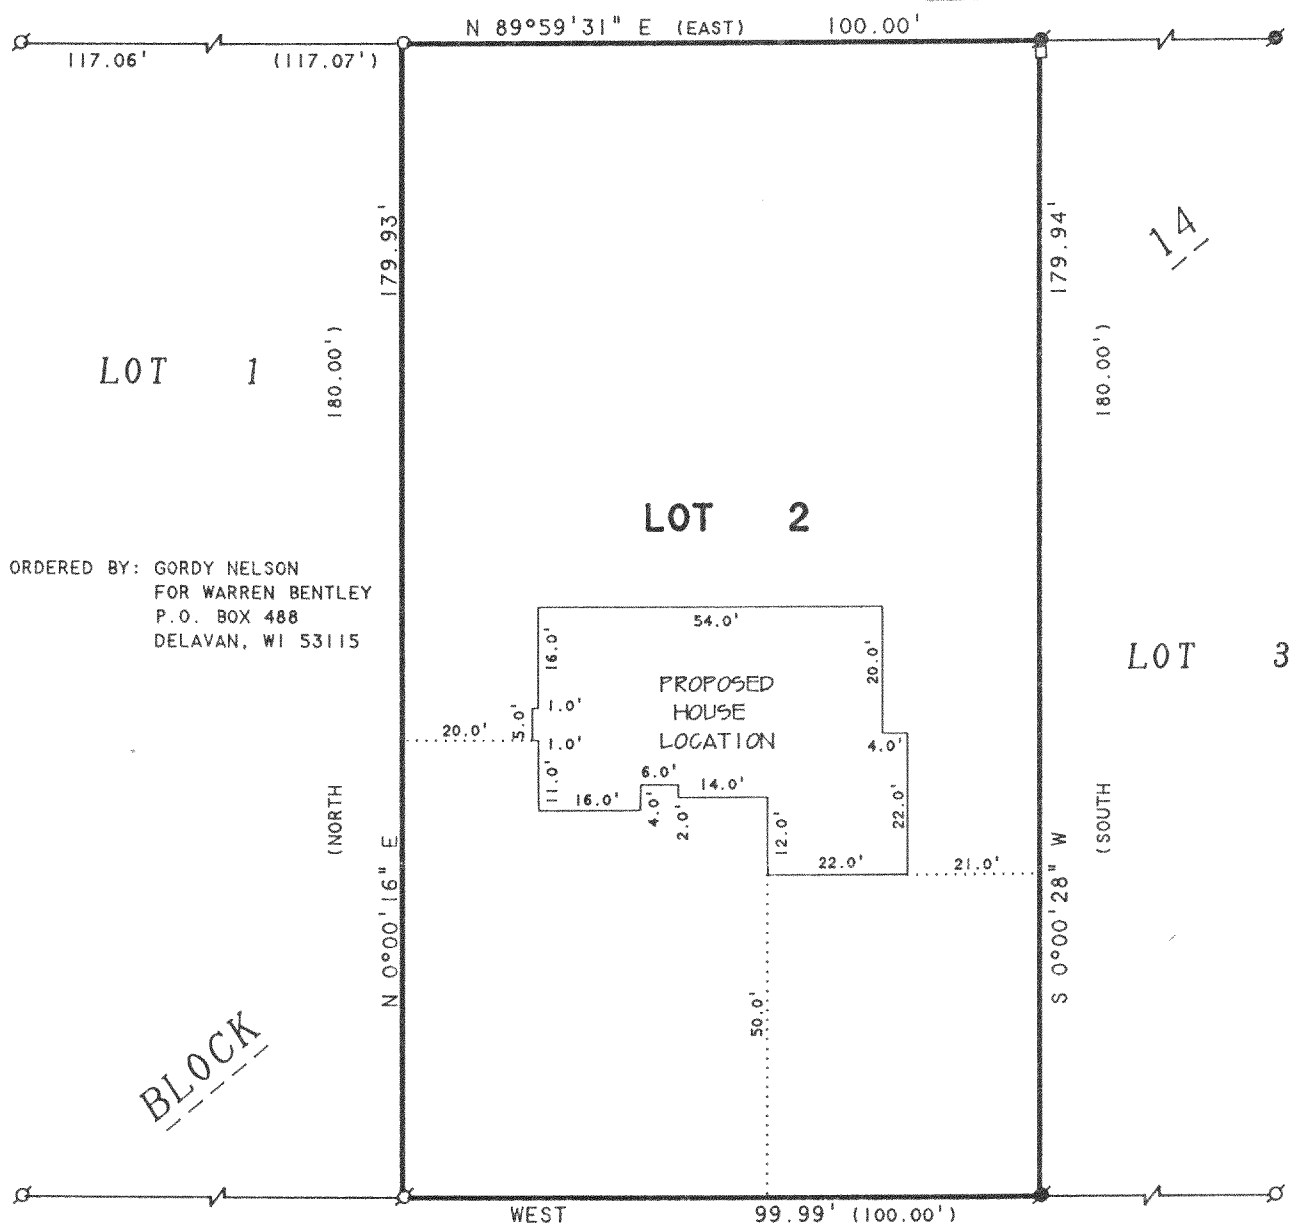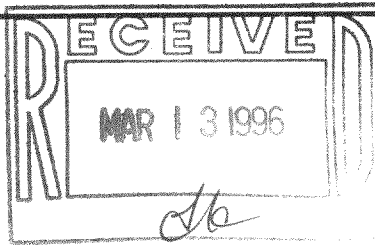


VALENCIA DRIVE

NOTE: BEARINGS ARE REFERENCED TO THE
RECORDED SUBDIVISION PLAT.

PLAT OF SURVEY OF

LOT 2, BLOCK 14, INLET OAKS SUBDIVISION NO. 5,
LOCATED IN T2N, R16E, WALWORTH COUNTY, WISCONSIN.

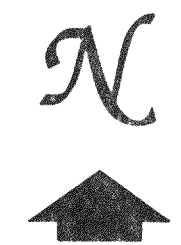

SCALE 1"=30'

LEGEND

- Ø -IRON PIPE FOUND
- -IRON ROD FOUND
- -IRON ROD SET
- -UTILITY PED.
- () -RECORDED AS

I, DAVID F. ABELL, DO HEREBY CERTIFY THAT I HAVE SURVEYED THE PROPERTY HEREON
DESCRIBED ACCORDING TO THE OFFICAL RECORDS AND THAT THE PLAT HEREON IS A
CORRECT REPRESENTATION OF THE PROPERTY LINES TO THE BEST OF MY KNOWLEDGE AND
BELIEF

David F. Abell

DAVID F. ABELL
WISCONSIN REGISTERED LAND SURVEYOR, S-1596

August 23, 1995

DATE JOB NUMBER - 95145
NOTE: THIS IS NOT A CERTIFIED COPY UNLESS SEALED.

FIN 5-40

216-2212