


PART OF THE SE FRAC. 1/4 OF SEC. 22  
TOWN 2 NORTH, RANGE 16 EAST  
WALWORTH COUNTY, WISCONSIN


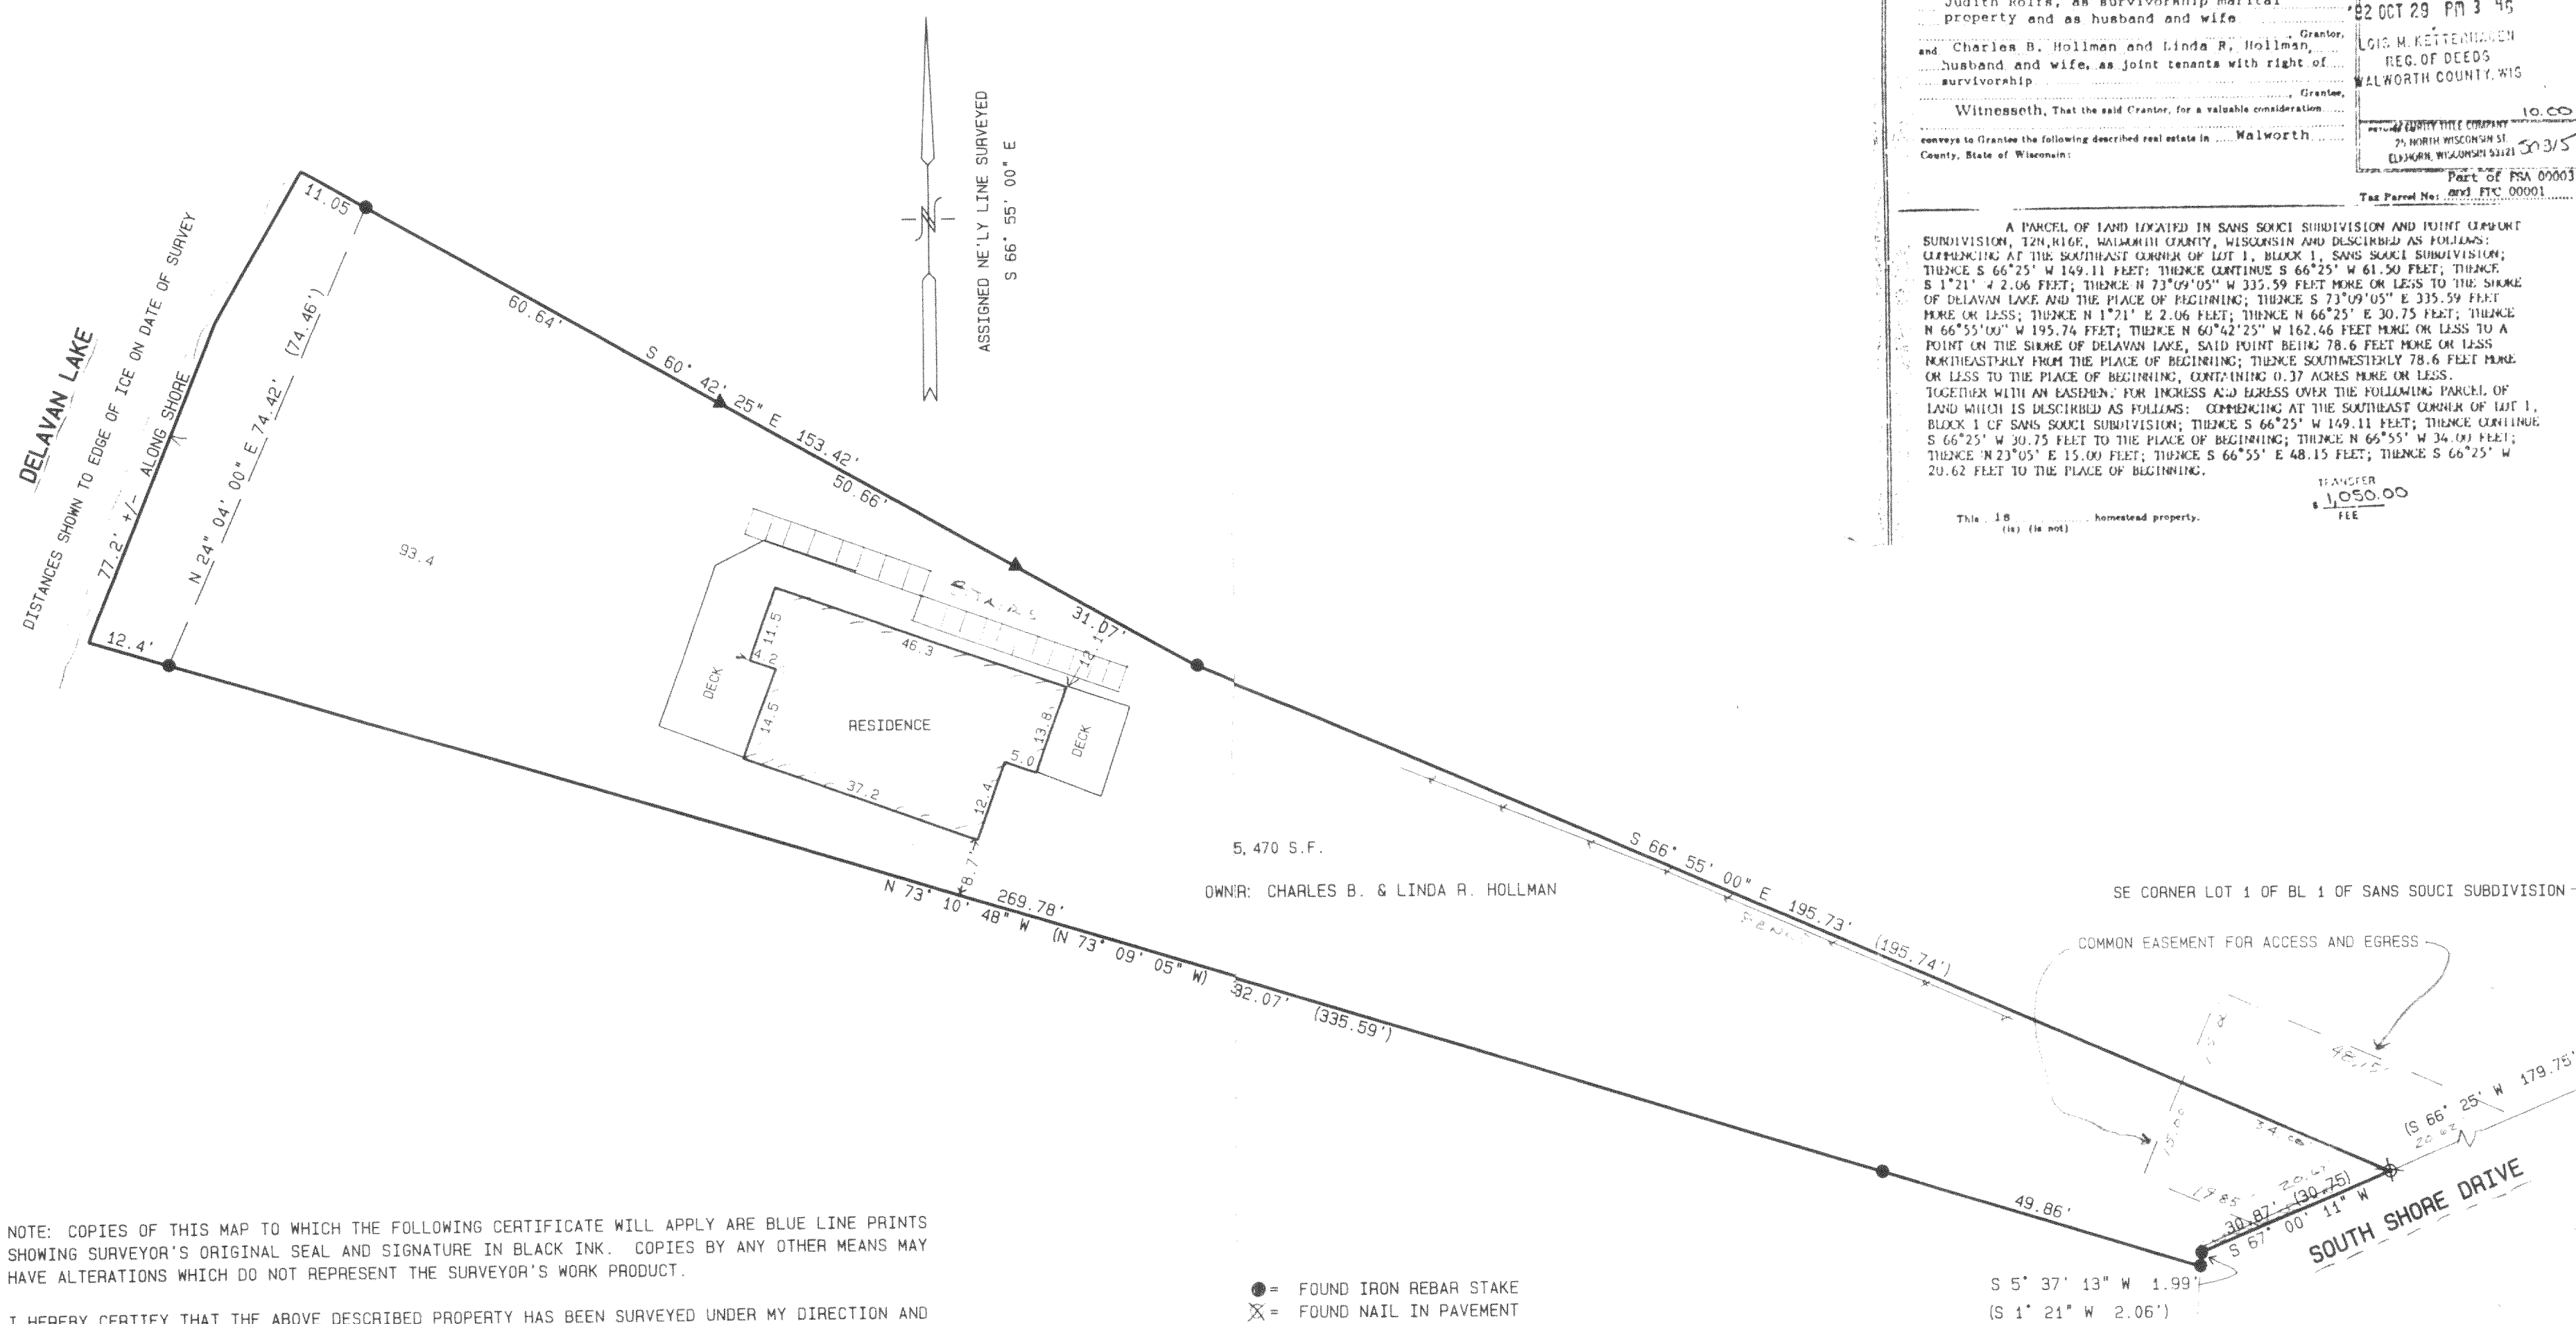


NOTE: COPIES OF THIS MAP TO WHICH THE FOLLOWING CERTIFICATE WILL APPLY ARE BLUE LINE PRINTS SHOWING SURVEYOR'S ORIGINAL SEAL AND SIGNATURE IN BLACK INK. COPIES BY ANY OTHER MEANS MAY HAVE ALTERATIONS WHICH DO NOT REPRESENT THE SURVEYOR'S WORK PRODUCT.


I HEREBY CERTIFY THAT THE ABOVE DESCRIBED PROPERTY HAS BEEN SURVEYED UNDER MY DIRECTION AND THAT THE ABOVE MAP IS A TRUE REPRESENTATION THEREOF AND SHOWS THE SIZE AND LOCATION OF THE PROPERTY AND ITS EXTERIOR BOUNDARIES. THIS SURVEY IS MADE FOR THE USE OF THE PRESENT OWNERS OF THE PROPERTY, AND ALSO THOSE WHO PURCHASE, MORTGAGE, OR GUARANTEE THE TITLE THERETO WITHIN ONE YEAR FROM THE DATE HEREOF.

DATED: 3-12-96

PETER S. GORDON R.L.S. 2101

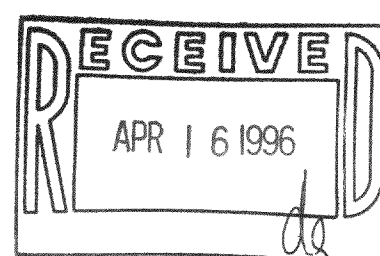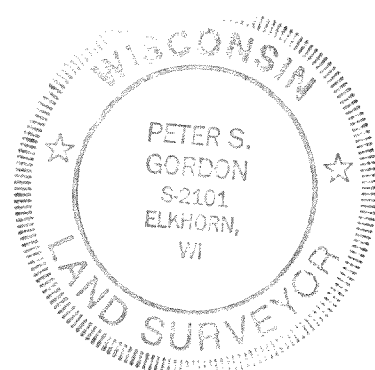

● = FOUND IRON REBAR STAKE  
 ✕ = FOUND NAIL IN PAVEMENT  
 ▼ = SET NAIL  
 (X X) = RECORDED AS

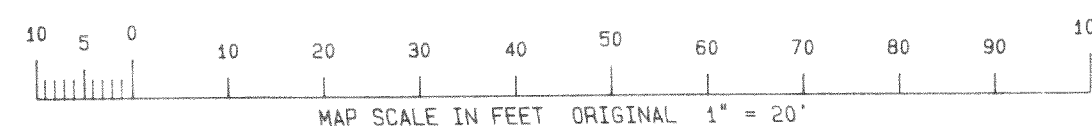

DOCUMENT NO. 244615 STATE BAR OF WISCONSIN FORM 1-1988 THIS SPACE RESERVED FOR RECORDING DATA  
RECORDED IN VOL 595  
PAGE 518  
62 OCT 29 PM 3 46  
LOIS M. KETTERING  
REG. OF DEEDS  
WALWORTH COUNTY, WIS  
Witneseth, That the said Cranton, for a valuable consideration  
conveys to Grath the following described real estate in Walworth  
County, State of Wisconsin:  
A PARCEL OF LAND LOCATED IN SANS SOUZI SUBDIVISION AND POINT CEMENT  
SUBDIVISION, 12N, 18E, WALWORTH COUNTY, WISCONSIN AND DESCRIBED AS FOLLOWS:  
COMMENCING AT THE SOUTHWEST CORNER OF LOT 1, BLOCK 1, SANS SOUZI SUBDIVISION;  
THENCE S 66°25' W 149.11 FEET; THENCE CONTINUE S 66°25' W 61.30 FEET; THENCE  
S 1°21' 42.06 FEET; THENCE N 73°09'05" W 335.59 FEET MORE OR LESS TO THE SHORE  
OF DELAVAN LAKE AND THE PLACE OF BEGINNING; THENCE S 73°09'05" E 335.59 FEET  
MORE OR LESS; THENCE N 1°21' 42.06 FEET; THENCE S 66°25' W 30.75 FEET; THENCE  
N 66°55'00" W 195.74 FEET; THENCE N 60°42'25" W 162.46 FEET MORE OR LESS TO A  
POINT ON THE SHORE OF DELAVAN LAKE, SAID POINT BEING 78.6 FEET MORE OR LESS  
NORTHWESTRALLY FROM THE PLACE OF BEGINNING; THENCE SOUTHWESTRALLY 78.6 FEET  
MORE OR LESS TO THE PLACE OF BEGINNING, CONTAINING 0.37 ACRES MORE OR LESS  
TOGETHER WITH AN EASEMENT FOR INGRESS AND EGRESS OVER THE FOLLOWING PARCEL OF  
LAND WHICH IS DESCRIBED AS FOLLOWS: COMMENCING AT THE SOUTHWEST CORNER OF LOT 1,  
BLOCK 1 OF SANS SOUZI SUBDIVISION; THENCE S 66°25' W 149.11 FEET; THENCE CONTINUE  
S 66°25' W 30.75 FEET TO THE PLACE OF BEGINNING; THENCE N 66°55' W 34.00 FEET;  
THENCE N 23°05' E 15.00 FEET; THENCE S 66°55' E 48.15 FEET; THENCE S 66°25' W  
20.62 FEET TO THE PLACE OF BEGINNING.

TRANSFER  
\$ 1050.00  
FEE

This is (a) \_\_\_\_\_, homestead property.  
(14) (16) not

WORK ORDERED BY: STEVE STILLING  
PRAIRIE TREE LANDSCAPING  
N 6411 HWY 12  
ELKHORN, WI.

**FARRIS, HANSEN & ASSOCIATES, INC.**  
Engineering, Architecture, Surveying  
7 Ridgway Court P.O. Box 437  
ELKHORN, WISCONSIN 53121  
Office: (414) 723-2098  
Fax: (414) 723-5886

REVISIONS

PROJECT NO.  
4480

DATE  
03/12/96

SHEET NO.  
1 OF 1

FSA-3A  
FPC-1

216-2250