

## N




STATE OF WISCONSIN)  
COUNTY OF WALWORTH) SS

A part of Lots 2 and 4 of Certified Survey No. 1224, recorded in Volume 5 of Certified Surveys, on pages 328 and 329, Document No. 78862 on May 21, 1982, in the Office of the Register of Deeds, Elkhorn, Wis., and being a parcel of land located in the SW<sup>1</sup>/<sub>4</sub> of Section 29, T 2 N, R 16 E, Walworth County, Wisconsin, described as follows: Commencing on the south line of North Shore Drive at the northeast corner of Lot 4 of said Certified Survey No. 1224; thence S0°47'00"E along the easterly line of said Certified Survey No. 1224, 345.00 feet to the place of beginning; thence S89°08'W parallel with the south line of said Lot 4, 275.00 feet; thence S0°47'E along the west line of said Lots 4 and 2, 50.00 feet; thence N89°08'E 225.00 feet; thence S0°47'E 320.00 feet to the southeast corner of Lot 3 of said Certified Survey No. 1224; thence S89°08'W 50.00 feet to the northeast corner of Lot 1 of said Certified Survey No. 1224; thence S0°47'E along the east line of said Lot 1, 486.23 feet more or less to the shore of Delavan Lake; thence northeasterly along the shore of Delavan Lake, 112.4 feet more or less to the southeast corner of said Lot 2; thence N0°47'W along the east line of said Lot 2, 805.80 feet more or less to the place of beginning, subject to easements of record.

and that the plat shown hereon is a correct representation thereof and shows the size and location of the property, its exterior boundaries, the location of all visible structures and dimensions of all principal buildings thereon, and the location of the proposed garage to be built on said property, boundary fences, apparent easements, roadways and visible encroachments, if any, and that I have surveyed the property hereon described, according to the official records to the best of my knowledge and belief.

May 26, 1995

George T. Dunham  
George T. Dunham, Surveyor

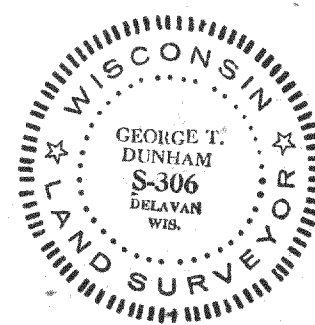

FA-1224-2  
FA-1224-4  
216-2259

