

**ABELL  
SURVEYING & MAPPING  
DELAVAN, WISCONSIN 53115  
414-728-6737**


PERPETUAL RIGHT-OF-WAY EASEMENT FOR  
INGRESS AND EGRESS TO LOT 28 AS  
RECORDED IN VOL. 663 ON PAGE 113 AS  
DOCUMENT NO. 602757.



SCALE 1"=20'

**LEGEND**

- ⊘ - IRON PIPE FOUND
- - IRON ROD FOUND
- - OVERHEAD UTILITY LINE
- ( ) - RECORDED AS

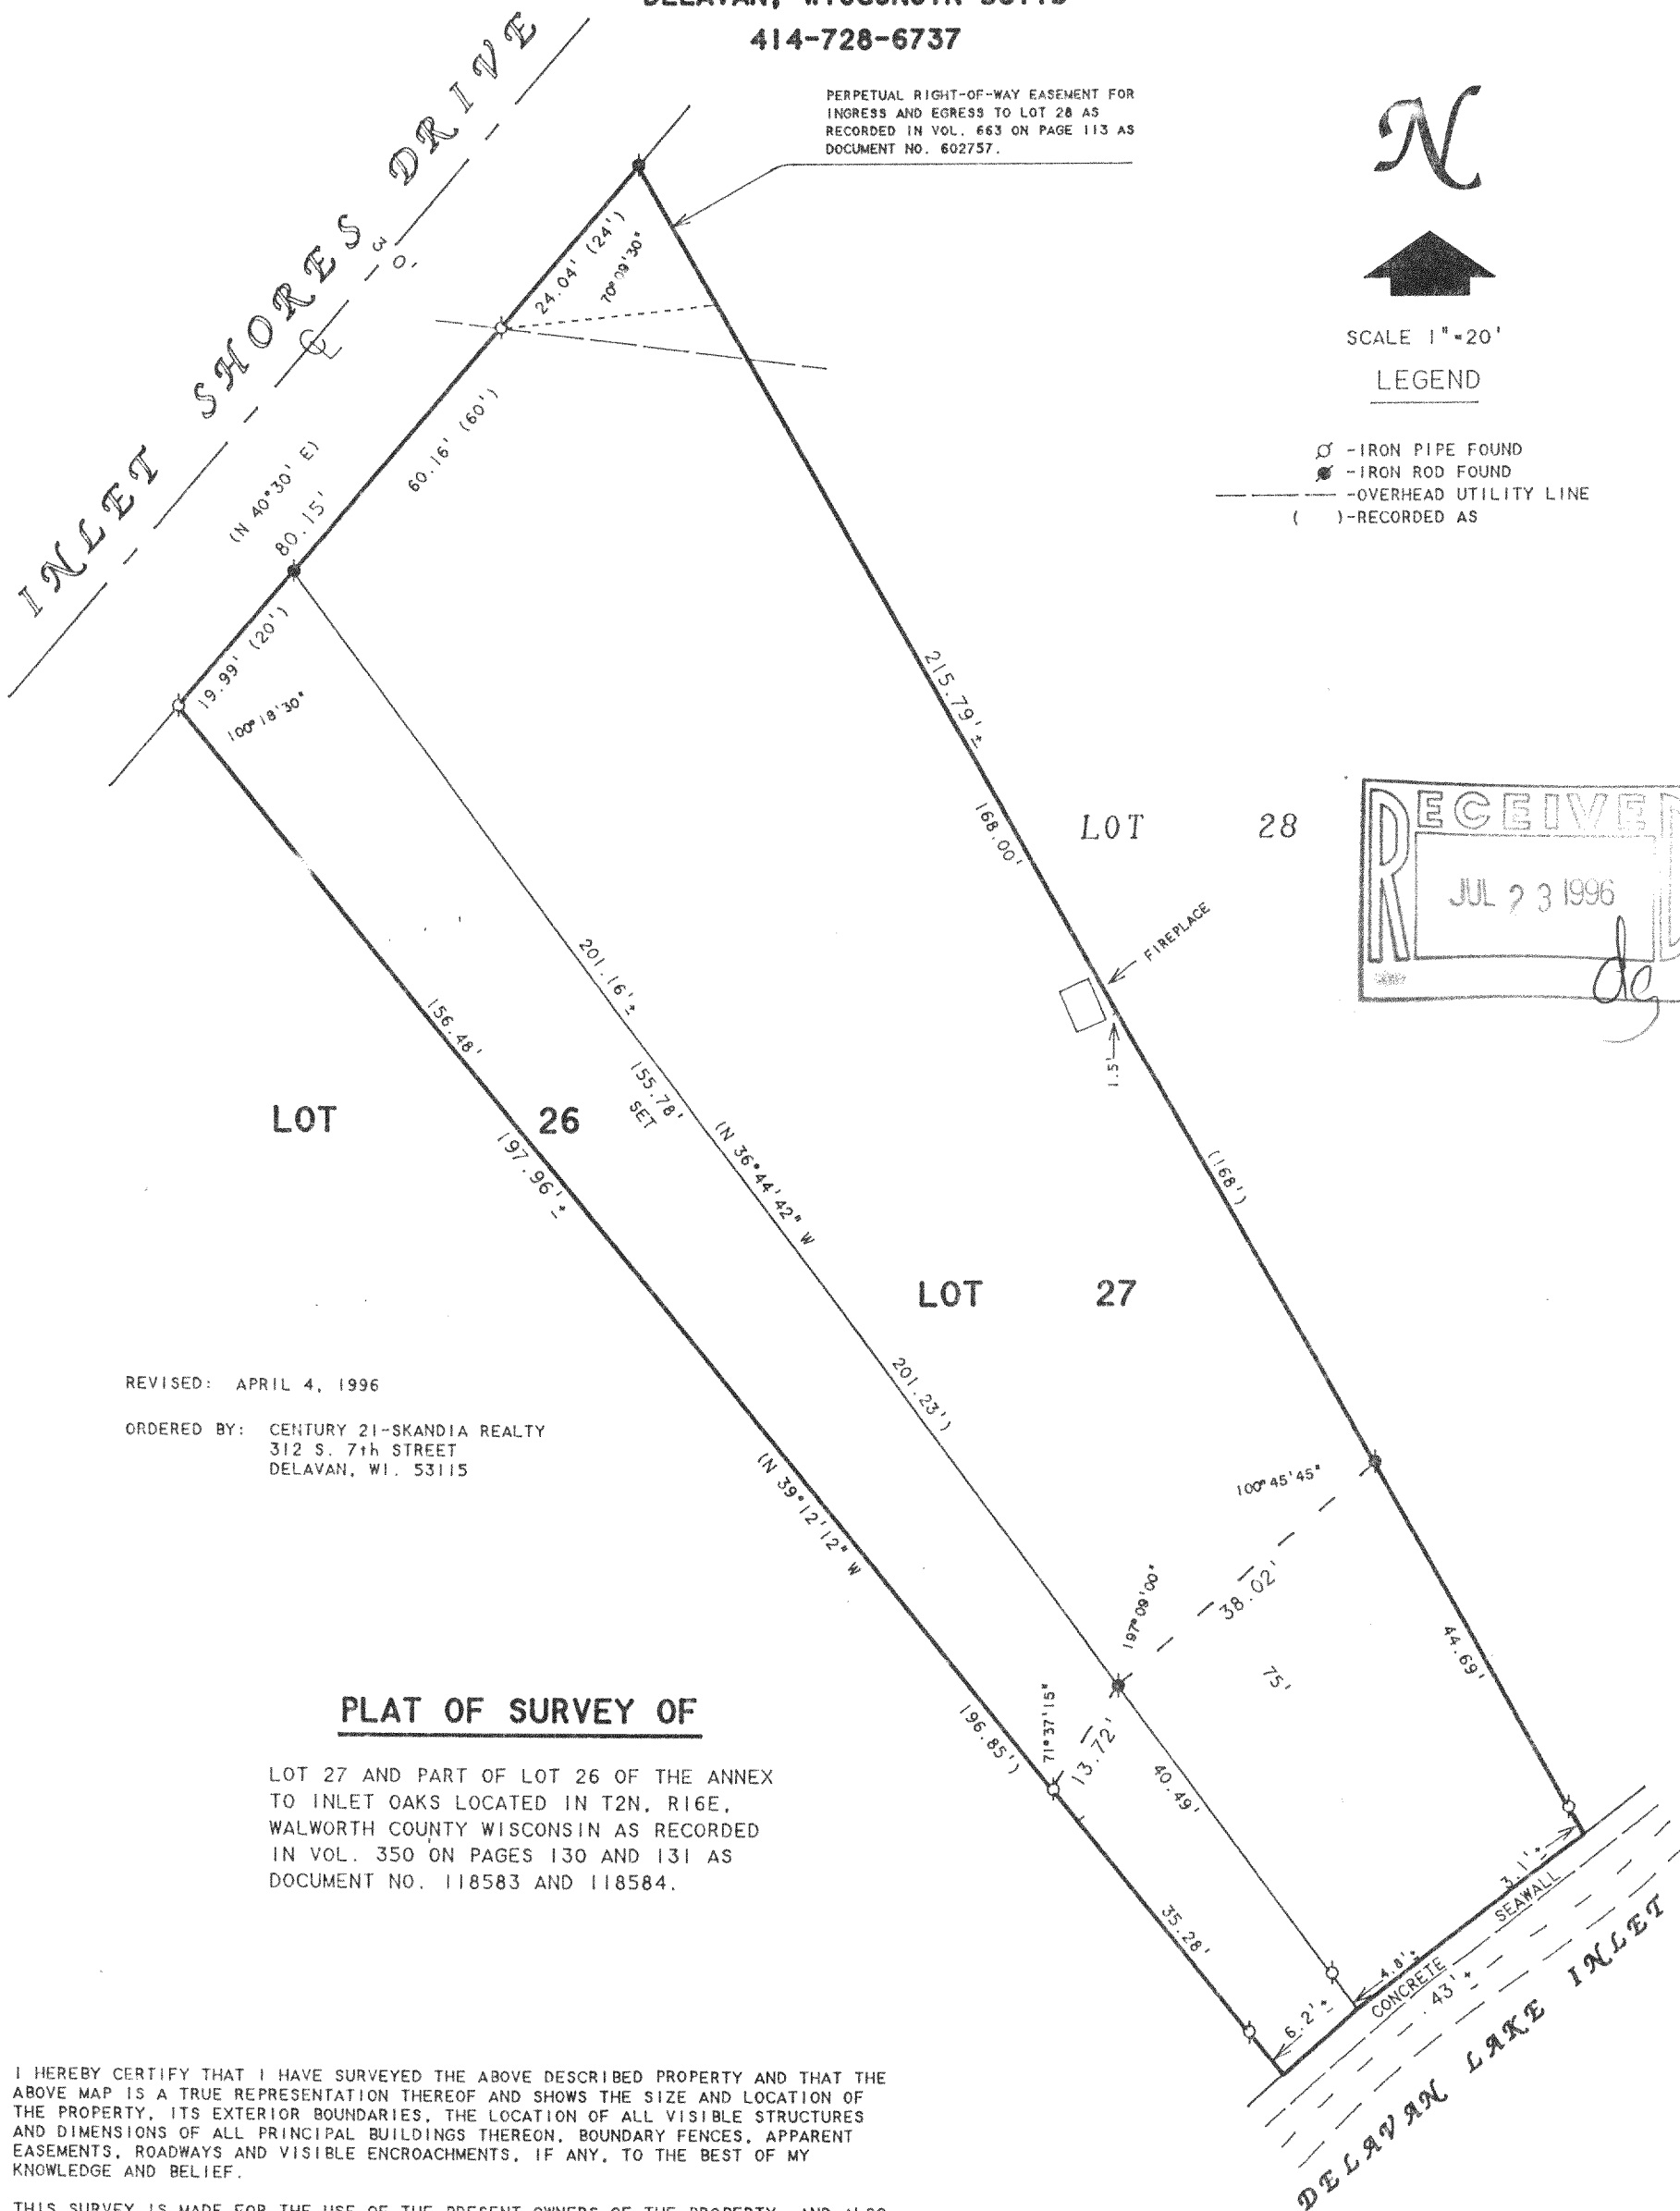

REVISED: APRIL 4, 1996

ORDERED BY: CENTURY 21-SKANDIA REALTY  
312 S. 7th STREET  
DELAVAN, WI. 53115

**PLAT OF SURVEY OF**

LOT 27 AND PART OF LOT 26 OF THE ANNEX  
TO INLET OAKS LOCATED IN T2N, R16E,  
WALWORTH COUNTY WISCONSIN AS RECORDED  
IN VOL. 350 ON PAGES 130 AND 131 AS  
DOCUMENT NO. 118583 AND 118584.

I HEREBY CERTIFY THAT I HAVE SURVEYED THE ABOVE DESCRIBED PROPERTY AND THAT THE ABOVE MAP IS A TRUE REPRESENTATION THEREOF AND SHOWS THE SIZE AND LOCATION OF THE PROPERTY, ITS EXTERIOR BOUNDARIES, THE LOCATION OF ALL VISIBLE STRUCTURES AND DIMENSIONS OF ALL PRINCIPAL BUILDINGS THEREON, BOUNDARY FENCES, APPARENT EASEMENTS, ROADWAYS AND VISIBLE ENCROACHMENTS, IF ANY, TO THE BEST OF MY KNOWLEDGE AND BELIEF.

THIS SURVEY IS MADE FOR THE USE OF THE PRESENT OWNERS OF THE PROPERTY, AND ALSO THOSE WHO PURCHASE, MORTGAGE, OR GUARANTEE THE TITLE THERETO WITHIN ONE (1) YEAR FROM DATE HEREON.

*David F. Abell*

DAVID F. ABELL  
WISCONSIN REGISTERED LAND SURVEYOR, S-1596

ORDERED BY: BRICE SOLTYS  
30 N. RAMMER AVE.  
ARLINGTON HEIGHTS, IL. 60004

*Feb. 20, 1992*

REVISED DATE: APRIL 4, 1996  
REVISED DATE: APRIL 20, 1992  
REVISED DATE: MARCH 19, 1992

DATE: Feb. 20, 1992  
JOB NUMBER - 92024  
NOTE: THIS IS NOT A CERTIFIED COPY UNLESS SEALED.

FIA-21A

216-2269