
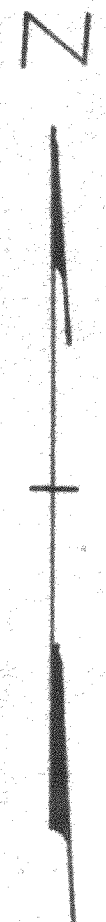


DUNHAM SURVEYING, S.C.  
 SURVEYING & SUBDIVIDING  
 DELAVAN, WISCONSIN 53115

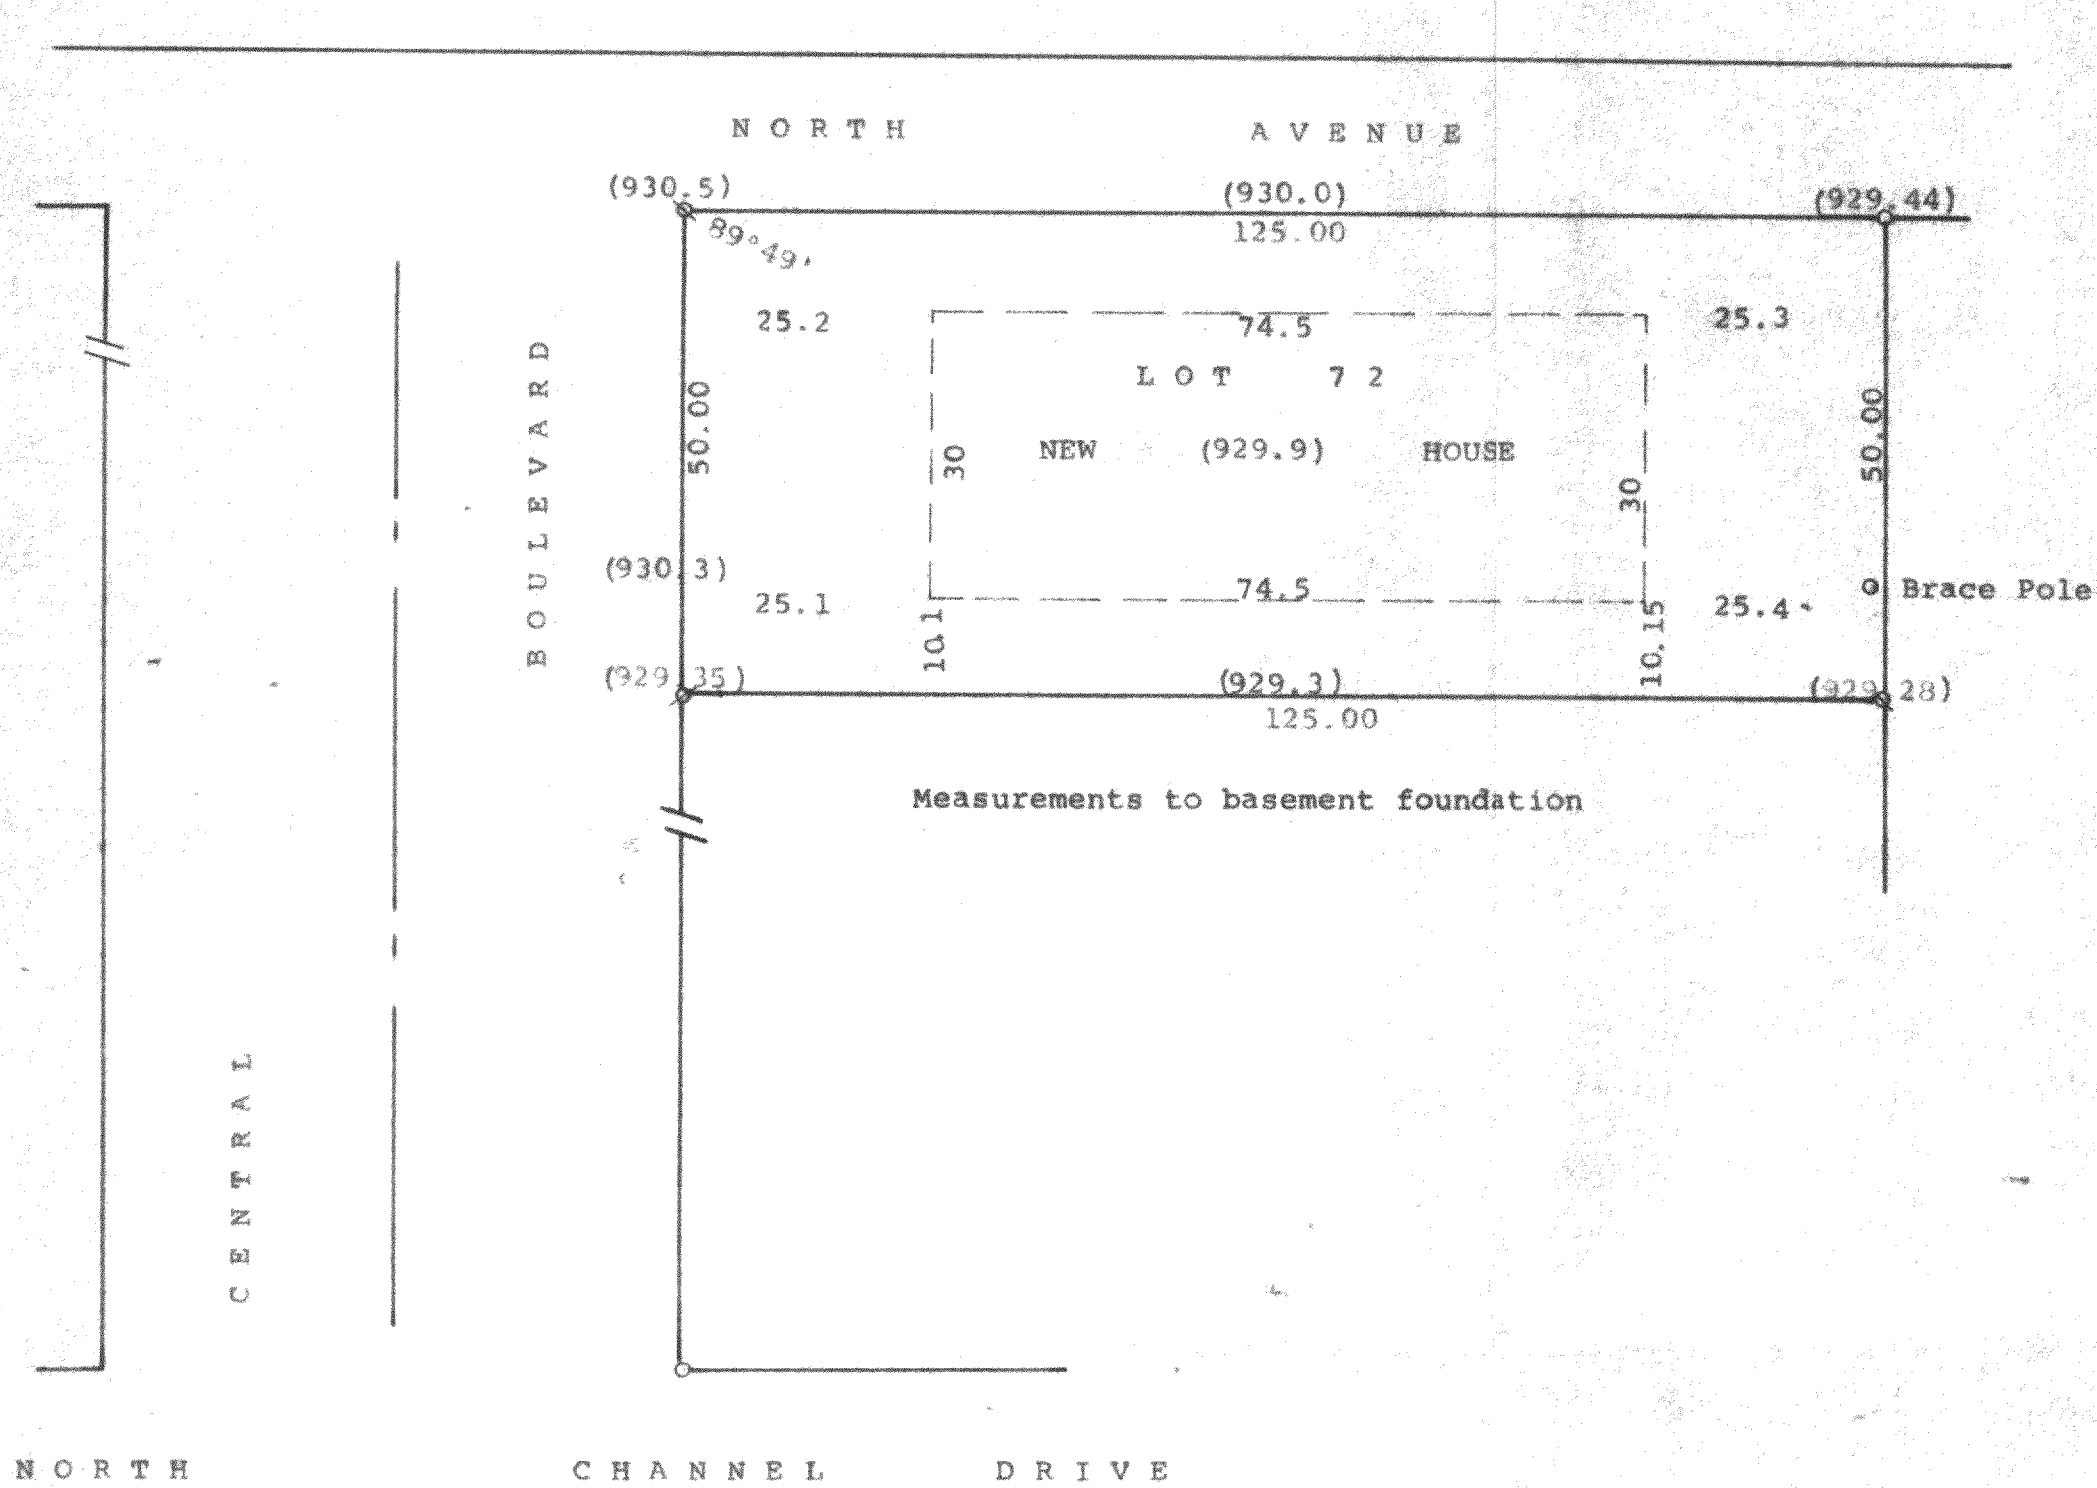

Scale - 1" = 20'  
 Ø = 1/2" Iron Pipe Found. Reset 1 1/4"  
 Iron Pipe  
 ⊗ = 1 1/4" Iron Pipe Set  
 ○ = 1 1/4" Iron Pipe Set  
 (0.00) = Elevations of land  
 929.00 Flood Plain Elevation  
 Survey ordered by: Lake Geneva Properties  
 816 Williams Street  
 Lake Geneva, WI 53147  
 Updating ordered by:  
 Deschner Building Contractors, Inc.  
 3338 North Shore Drive  
 Delavan, WI 53115

STATE OF WISCONSIN)  
 COUNTY OF WALWORTH) SS

I, George T. Dunham, Surveyor, certify that I have surveyed the property described as follows:  
 Lot 72 in Lake Delavan Highlands, a subdivision located in the South 1/2 of the Southeast Fractional 1/4 of Section 31, T 2 N, R 16 E, Walworth County, Wisconsin,

and that the plat shown above is a true representation thereof and shows the size and location of the property, its exterior boundaries, the location of all visible structures and dimensions of all principal buildings thereon, boundary fences, apparent easements, roadways and visible encroachments, if any, and that I have surveyed the property hereon described, according to the official records, to the best of my knowledge and belief.  
 December 5, 1994

Updated Feb. 27, 1995 to show size and location of proposed house  
 Updating March 31, 1995 to show size and location of existing house

*George T. Dunham*  
 George T. Dunham, Surveyor

