
DUNHAM SURVEYING, S. C. SURVEYING & SUBDIVIDING DELAVAN, WISCONSIN 53115

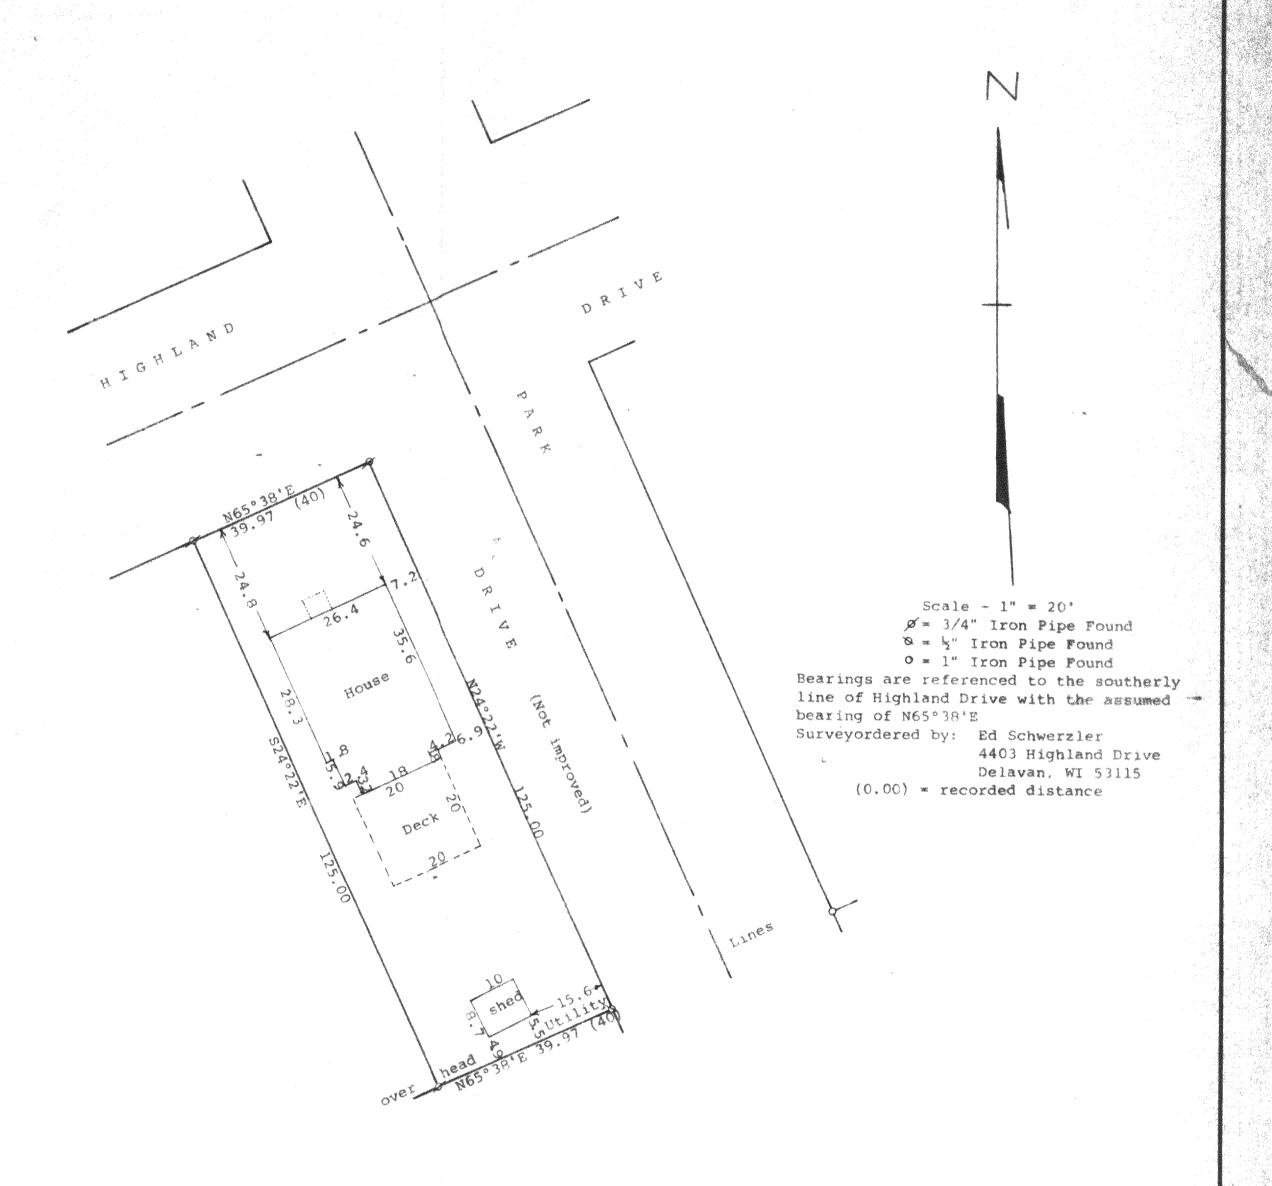

STATE OF WISCONSIN) SS

I, George T. Dunham, Surveyor, certify that I have surveyed the property described as follows:

Lot 1 in Block 19 of Delavan Lake View Crest located in Section 31, T 2 N, R 16 E, Walworth County, Wisconsin,

and that the plat shown hereon is a correct representation thereof and shows the size and location of the property, its exterior boundaries, the location of all visible structures and dimensions of all principal buildings thereon, boundary fences, apparent easements, roadways and visible encroachments, if any, and that I have surveyed the property hereon described, according to the official records, to the best of my knowledge and belief.

June 23, 1995

George Dunham, Surveyor



